

MISSISSIPPI DEPARTMENT OF NATURAL RESOURCES

Bureau of Land and Water Resources

Southport Mall

P.O. Box 10631

Jackson, Mississippi 39209

WATER WELL DRILLERS LOG

WAYNE  
Q 34

10-9-84

Griner Drilling Service, INC.

Wayne

date well completed

firm name

county well located

LANDOWNER:  
Osborn Heirs Co.  
P.O. Box 17968  
San Antonio, Tx 78286  
(mailing address)

description of formations encountered	from	to
clay	0	150
sand	150	189

WELL LOCATION: 330'S + 330'W  
sec. 22 T 70 N R 9 E OF ONE/100  
No. 2 Thompson Creek  
U.S.A. (distance) Field (nearest town)

WELL PURPOSE: outfield supply  
(home, irrigation, municipal, industrial)

- WELL COMPLETION DATA:
- (1) diameter (inches) 4"
  - (2) total depth (feet) 189'
  - (3) static water level (feet) 60 <sup>below</sup> above top of ground.
  - (4) casing steel 189'  
(material) (depth)  
4" if telescope see back.  
(size)
  - (5) screen 42' 147'  
(length) (depth to top)  
4" perforated  
(size) (material)
  - (6) pump AC 75-80  
(HP) (yield gpm)  
(type power)
  - (7) electric log (yes or no)  
(organization running log)
  - (8) how well bottom plugged orange peel

DEPT. OF NATURAL RESOURCES  
BUREAU OF LAND & WATER RESOURCES


OCT 22 1984

RECEIVED

DRILLERS REMARKS:

If well telescopes please  
sketch and show depths.

GROUND LEVEL

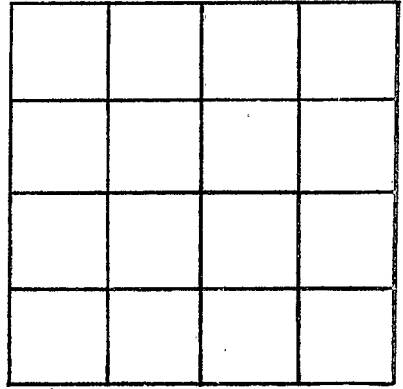

SECTION \_\_\_\_\_

Please indicate well location X.

ADDITIONAL INFORMATION

If more than one screen,  
show locations of each on sketch.