

MISSISSIPPI DEPARTMENT OF NATURAL RESOURCES

Bureau of Land and Water Resources

Southport Mall

P.O. Box 10631

Jackson, Mississippi 39209

WATER WELL DRILLERS LOG

Wayne
 35 294 03 D
 ()

CODED

Griner Drilling Service, Inc.

Wayne

6-26-91 date well completed

firm name

county well located

Lease: No. 1 U.S.A. 26-9

LANDOWNER:	description of formations encountered	from	to
Norcen Explorer, Inc 550 Westlake Blvd. Suite 350	clay	0	90
Houston, Texas (mailing address) 77079	sand, gravel	90	200
WELL LOCATION: 1320' N + 500' W sec. 26 T 70 N R 9 E of Thompson Ch. Field	clay	200	231
(distance) (direction) (nearest town)			
WELL PURPOSE: oilfield (home, irrigation, municipal, industrial)			
WELL COMPLETION DATA:			
(1) diameter (inches) 3"			
(2) total depth (feet) 231'			
(3) static water level (feet) 10' below top of ground.			
(4) casing PVC, 170' (material) (depth)			
3" (size) if telescope see back.			
(5) screen 30' 170' to 200' (length) (depth to top)			
3" PVC screen (size) (material)			
(6) pump — 90 (HP) (yield gpm)			
Air Compressor (type power)			
(7) electric log (yes or no)			
(organization running log)			
(8) how well bottom plugged back wash valve			
DRILLERS REMARKS:			


RECEIVED

JUL 06 1991

Dept. of Environmental Quality
Bureau of Land & Water Resources

If well telescopes please
sketch and show depths.

GROUND LEVEL

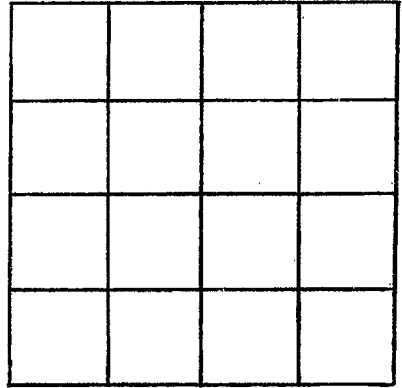

SECTION _____

Please indicate well location X.

ADDITIONAL INFORMATION

If more than one screen,
show locations of each on sketch.