

WADSWORTH  
 Q 36  
 6-25-85

MISSISSIPPI  
 BOARD OF WATER COMMISSIONERS  
 416 North State Street  
 Jackson, Mississippi 39201

CODED

WATER WELL DRILLERS LOG

TOM GRIFFIN

PLUMBING & WELL SERVICE, INC.

Wadsworth

6-25 1985 date well completed  
 firm name  
 county well located

LANDOWNER: TXO  
 111 Capital Building  
 Jackson, MS 39201  
 (mailing address)

description of formations encountered	from to	
Clay	1	10
Sand	10	25
Clay	25	60
P-Grauel	60	220

WELL LOCATION:  
 sec. 35 T 7N R 9E  
 3 miles SE of Osoto  
 (distance) (direction) (nearest town)

WELL PURPOSE: art. well  
 (home, irrigation, municipal, industrial)

- WELL COMPLETION DATA:
- diameter (inches) 3"
  - total depth (feet) 220'
  - static water level (feet) 10' <sup>below</sup> top of ground. <sub>above</sub>
  - casing PVC, 180' (material) (depth)  
 N/A (size) if telescope see back.
  - screen 40' 180' (length) (depth to top)  
 40' PVC (size) (material)
  - pump air lift 100 (HP) (yield gpm)  
 diesel (type power)
  - electric log NO (yes or no)  
 N/A (organization running log)
  - how well bottom plugged BWV

USA 35-6-#1

1986'S + 1988'S

OF NW/4 COR SEC 35-7N-9W


RECEIVED

NOV 20 1985

DRILLERS REMARKS:

If well telescopes please sketch and show depths.

GROUND LEVEL

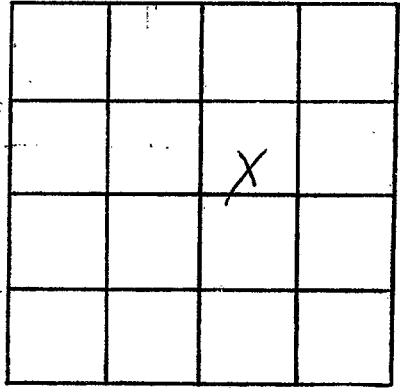

SECTION \_\_\_\_\_

Please indicate well location X.

ADDITIONAL INFORMATION

If more than one screen,  
show locations of each on sketch.