

Wayne  
4-8-76  
Q 2000

MISSISSIPPI  
BOARD OF WATER COMMISSIONERS  
416 North State Street  
Jackson, Mississippi 39201

WATER WELL DRILLERS LOG


April 8 1976 Roy West Waterworks Wayne  
date well completed firm name county well located

LANDOWNER: Dennis Earl	description of formations encountered	from	to
Horizon	clay	0	12
Rt 5 waynesboro (mailing address)	sandy clay	12	30
	clay	30	50
	sand	50	100
<b>WELL LOCATION:</b>			
sec. 1 T. 7 <sup>N</sup> R. 9 <sup>E</sup> 2.0 miles S.E. of Laurel (distance) (direction) (nearest town)			
<b>WELL PURPOSE:</b> Home (home, irrigation, municipal, industrial)			
<b>WELL COMPLETION DATA:</b>			
(1) diameter (inches) 2			
(2) total depth (feet) 100			
(3) static water level (feet) 45 below top of ground.			
(4) casing PVC 95 (material) (depth)			
(size) if telescope see back.			
(5) screen 5 95 (length) (depth to top)			
1 1/2 St Steel (size) (material)			
(6) pump 1 8 (HP) (yield gpm)			
PEA (type power)			
(7) electric log NO (yes or no)			
(organization running log)			
(8) how well bottom plugged wash well			
<b>DRILLERS REMARKS:</b>			

RECEIVED  
MAY 10 1976  
MISSISSIPPI BOARD OF WATER COMMISSIONERS

If well telescopes please sketch and show depths.

GROUND LEVEL

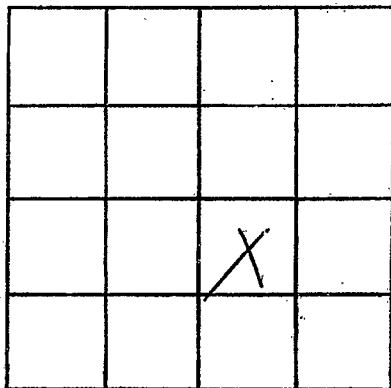

SECTION \_\_\_\_\_

Please indicate well location X.

ADDITIONAL INFORMATION

If more than one screen,  
show locations of each on sketch.