

Wayne
 Q 2001
 9/28/76

MISSISSIPPI
 BOARD OF WATER COMMISSIONERS
 416 North State Street
 Jackson, Mississippi 39201

WATER WELL DRILLERS LOG

Sept 28 1976 Roy West Water Wells Wayne
 date well completed firm name county well located

| LANDOWNER: <u>E.C. Loundrum</u> | description of formations encountered | from | to |
|---------------------------------|---------------------------------------|-------------|-----------|
| <u>Rt 2 Richton</u> | | <u>Clay</u> | <u>0</u> |
| | <u>loamy clay</u> | <u>28</u> | <u>40</u> |
| | <u>sand</u> | <u>40</u> | <u>60</u> |


(mailing address)

WELL LOCATION:
 sec. 33 T 7 N R 9 E
15 miles N of Richton
 (distance) (direction) (nearest town)

WELL PURPOSE: home
 (home, irrigation, municipal, industrial)

- WELL COMPLETION DATA:
- (1) diameter (inches) 2 in
 - (2) total depth (feet) 60
 - (3) static water level (feet) 35 below above top of ground.
 - (4) casing PVC 55
 (material) (depth)
 (size) if telescope see back.
 - (5) screen 5 55
 (length) (depth to top)
1/4" st steel
 (size) (material)
 - (6) pump 1/2 6
 (HP) (yield gpm)
REA
 (type power)
 - (7) electric log no
 (yes or no)
 - (organization running log)
 - (8) how well bottom plugged washed


DRILLERS REMARKS:

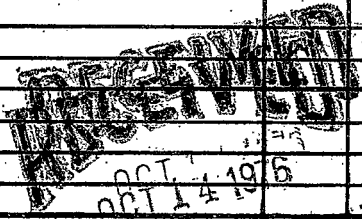

MISS. BD. OF WATER COMM

If well telescopes please sketch and show depths.

GROUND LEVEL

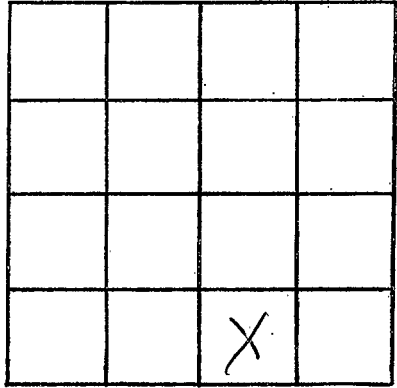

SECTION 32

Please indicate well location X.

ADDITIONAL INFORMATION

If more than one screen, show locations of each on sketch.