

C. P. CLARK

WATER WELL DRILLING

ROUTE 2

MISSISSIPPI BOARD OF WATER COMMISSIONERS LAUREL, MISS. 39440

416 North State Street

134 Jackson, Mississippi 39201

WATER WELL DRILLERS LOG

WAYNE
Q 2002
11-14-77

11/14/77

C.P. Clark

Wayne

date well completed:

firm name

county well located

LANDOWNER:

Alfred Grebbie

description of formations encountered

from

to

Rt #4

Laurel Miss 39440
(mailing address)

Surface Clay
Red Clay
White Clay
Medium Sand

0 5
5 14
14 94
94 103

WELL LOCATION:

sec. 22 T. 7(N) S. R. 9 E (W)
5 miles S of Stroud
(distance) (direction) (nearest town)

WELL PURPOSE:

(home, irrigation, municipal, industrial)

WELL COMPLETION DATA:

- (1) diameter (inches) 2
- (2) total depth (feet) 103
- (3) static water level (feet) 74 below above top of ground.
- (4) casing Galvalume 98 (material) (depth)
- (size) If telescope see back.
- (5) screen 5 98 (length) (depth to top)
1 1/4 Solid S.S. (size) (material)
- (6) pump 1 8 (HP) (yield gpm)
- (type power)
- (7) electric log No (yes or no)

(organization running log)

(8) how well bottom plugged Bwu

DRILLERS REMARKS:


Set 12A
Jet @ 96 ft

RECEIVED
NOV 17 1977

MISS. BD. OF WATER COMMISSIONERS

If well telescopes please sketch and show depths.

GROUND LEVEL

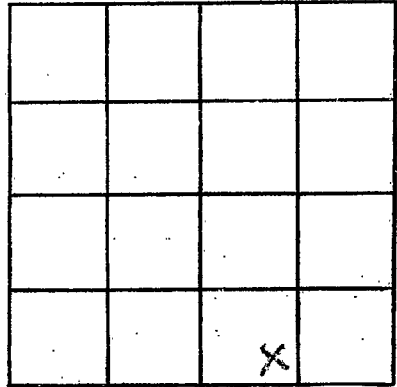

SECTION 2-2

Please indicate well location X.

ADDITIONAL INFORMATION

If more than one screen, show locations of each on sketch.