

WAYNE
 Q 2003
 May 25, 1979

MISSISSIPPI
 BOARD OF WATER COMMISSIONERS
 416 North State Street
 Jackson, Mississippi 39201

WATER WELL DRILLERS LOG

May 25 1979 Porter Drilling, Inc. Wayne
 date well completed firm name county well located

LANDOWNER: Jake McLean
 Rt 3 Box 419
 Magnolia, Miss.
 (mailing address)

description of formations encountered	from	to
clean	0	30
soft med sand	30	60
med soft sand	60	75
med soft sand	75	90
soft fine sand		
med soft clay	90	105
still in sand		

WELL LOCATION:
 sec. 12 T 7 N R 9 E
 2 1/2 miles S.E. of Hattiesburg
 (distance) (direction) (nearest town)

WELL PURPOSE: home
 (home, irrigation, municipal, industrial)

- WELL COMPLETION DATA:
- (1) diameter (inches) 2"
 - (2) total depth (feet) 84'
 - (3) static water level (feet) 30' below top of ground
 - (4) casing P.V.C. 79' (material) (depth)
 2" (size) If telescope see back.
 - (5) screen 5' 79' (length) (depth to top)
 2" (size) bsbt S.S. (material)
 - (6) pump 1 12 (HP) (yield gpm)
 elec. (type power)
 - (7) electric log (yes or no)
- (organization running log)

42' 1" P.V.C. drop pipe

Miss. Board of Water Comm.


JUN 18 1979

RECEIVED

DRILLERS REMARKS:
 2" backwash valve

If well telescopes please sketch and show depths.

GROUND LEVEL

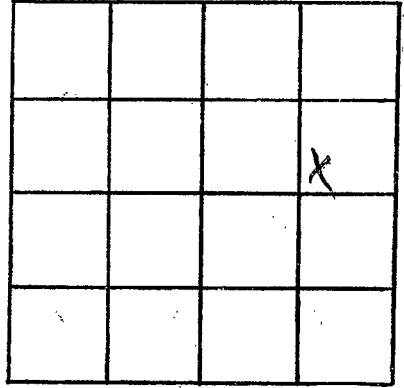

SECTION 12

Please indicate well location X.

ADDITIONAL INFORMATION

If more than one screen,
show locations of each on sketch.