

# MISSISSIPPI DEPARTMENT OF NATURAL RESOURCES

Bureau of Land and Water Resources

P.O. Box 10631

Jackson, Mississippi 39209

WATER WELL DRILLERS LOG

COUNTY WELL LOCATED <b>WAYNE</b>	
WELL NUMBER <b>Q</b>	CODED
DATE WELL COMPLETED <b>12/22/88</b>	

PERMIT NUMBER <b>205</b>
NAME OF DRILLING FIRM <b>CARD'S WELL SER</b>
<b>BOKERATONNA, MS</b>

NAME & MAILING ADDRESS OF LANDOWNER <b>ENERGY DRILLING CO</b>			
<b>P.O. BOX 905</b>			
<b>NATCHEZ MS. 39128</b>			
WELL LOCATION:	SEC	TOWNSHIP	RANGE
	<b>26</b>	<b>7</b>	<b>(N) 9 (E)</b>
DISTANCE	DIRECTION	NEAREST TOWN	
<b>6 1/2</b> Miles	<b>S</b>	<b>STREET FORD</b>	
OTHER LANDMARK			
WELL PURPOSE: Home, Irrigation, Municipal, Industrial, Fish Pond, etc. <b>OIL WELL</b>			

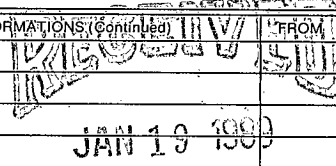

PUMP DATA		
PUMP TYPE (Circle One): Submersible, Turbine, Jet, Flowing Well, Other (Describe) <b>AIR LIFT</b>		
POWER TYPE (Circle One): Electric, Tractor, Diesel, Gasoline, Butane, Other (Describe) <b>H/P</b>		
Pump Capacity (GPM)	No. of Stages	Setting Depth <b>FT.</b>
PUMP TEST		
Well yielded <b>30</b> GPM with a drawdown of <b>10</b> ft. after <b>10</b> hours of pumping		

WELL DATA		
Well Depth <b>165</b>	Casing Diameter (In.) <b>4"</b>	Casing Length (Ft.) <b>165</b>
Type of Casing <b>QUC</b>	Hole Depth <b>165</b>	Depth to Static Water Level <b>40'</b>
TYPE OF COMPLETION: (Circle One or More): Gravel Packed, Underreamed, Telescoped, Natural Development, Open Hole, Other (Describe) <b>QUC</b>		
Top of Lap Pipe or Reduction in Casing <b>FEET</b> IF TELESCOPED OR MORE THAN ONE SCREEN: USE BACK PAGE		

LOG DATA	
TYPE OF LOG RUN (Circle One): No Log Run, Electric, Gamma Ray, Density, Sonic, Neutron, Other (Describe)	
Name of Organization Running Log	

SCREEN DATA		
Diameter - Inches <b>4"</b>	Length - Feet <b>60</b>	Slot Size - Inches <b>20</b>
Screen Type <b>QUC</b>	Depth to Bottom - Feet <b>165</b>	

GEOLOGIC DATA (Office Use Only)			
Surface Elev.	Geologic Unit	Unit Thickness	Depth to Top
Subs. SWL	Date	Analysis	Aquifer Test
Driller's Remarks <b>SAWED SCREEN</b>			

DESCRIPTION OF FORMATIONS ENCOUNTERED	FROM	TO	FORMATIONS (Continued)	FROM	TO	
TOP SOIL	0	1				
CLAY	1	15				
CLAY + SAND	15	35				
BIVE CLAY	35	97				
SAND	97	100				
SAND + CLAY	100	107				
CR. SD + GRAVEL	107	135				
MED. SD.	135	165				

IF MORE SPACE IS NEEDED, USE BACK

If well telescopes please  
sketch and show depths.

---

GROUND LEVEL

---




SECTION \_\_\_\_\_

Please indicate well location X.

---

ADDITIONAL INFORMATION

---

If more than one screen,  
show location of each on sketch.

---