

MISSISSIPPI DEPARTMENT OF ENVIRONMENTAL QUALITY

Office of Land and Water Resources

P. O. Box 10631
Jackson, MS 39289-0631
WATER WELL DRILLERS LOG

COUNTY WELL LOCATED
WAYNE

WELL NUMBER 12007 CODED

DATE WELL COMPLETED 8/28/93

PERMIT NUMBER 205

NAME OF DRILLING FIRM
CARR'S WELL SER
BUCKATUNNA, MS.

NAME & MAILING ADDRESS OF LANDOWNER
21 C. HUNTING CLUB
RT. 1 BOX 27
RIGHTON, MS.

WELL LOCATION: SEC 36 TOWNSHIP 7 N RANGE 9 E
S

DISTANCE _____ MILES _____ OF _____

DIRECTION _____ NEAREST TOWN _____

OTHER LANDMARK _____

WELL PURPOSE: Home, Irrigation, Municipal, Industrial, Fish Pond, etc.
CLUB

PUMP DATA

PUMP TYPE (Circle One): Submersible, Turbine, Jet Flowing Well, Other (Describe) _____

POWER TYPE (Circle One): Electric, Tractor, Diesel, Gasoline, Butane, Other (Describe) _____ H/P 1

Pump Capacity (GPM)	No. of Stages	Setting Depth
<u>10</u>	<u>2</u>	<u>60</u> FT.

PUMP TEST

Well yielded 15 GPM with a drawdown of _____ ft. after 1 hours of pumping

WELL DATA

Well Depth	Casing Diameter (In.)	Casing Length (Ft.)
<u>120</u>	<u>2"</u>	<u>115</u>
Type of Casing	Hole Depth	Depth to Static Water Level
<u>PVC</u>	<u>120</u>	<u>19</u>

LOG DATA

TYPE OF LOG RUN (Circle One): No Log Run, Electric, Gamma Ray, Density, Sonic, Neutron, Other (Describe) _____

Name of Organization Running Log _____

TYPE OF COMPLETION: (Circle One or More): Gravel Packed, Underreamed, Telescoped, Natural Development, Open Hole, Other (Describe) _____

GEOLOGIC DATA (Office Use Only)

Surface Elev.	Geologic Unit	Unit Thickness	Depth to Top
Subs. SWL	Date	Analysis	Aquifer Test

WELL GROUTED TO A DEPTH OF 30 FEET
Type Grout (circle one): Cement Bentonite, or Mix

Driller's Remarks _____

Top of Lap Pipe or Reduction in Casing _____

FEET IF TELESCOPED OR MORE THAN ONE SCREEN: USE BACK PAGE

SCREEN DATA

Diameter - Inches	Length - Feet	Slot Size - Inches
<u>2"</u>	<u>5</u>	<u>8</u>
Screen Type	Depth to Bottom - Feet	
<u>PVC</u>	<u>120</u>	

DESCRIPTION OF FORMATIONS ENCOUNTERED	FROM	TO
TOP SOIL	0	1
PR. & SR. CLAY	1	10
FN, WH. SD.	10	17
FN / MED. WH. SD.	17	19
PR. & SR. CLAY	19	26
BL. CLAY	26	35
GR. "	35	90
FN, FN, SD CLAY	90	102
FN, WH. SD.	102	109
FN, MED. SR. SD.	109	120

FORMATIONS CONTINUED ON PAGE _____

RECEIVED


OCT 08 1993

Dept. of Environmental Quality
Office of Land & Water Resources

IF MORE SPACE IS NEEDED, USE BACK

If well telescopes please
sketch and show depths.

GROUND LEVEL

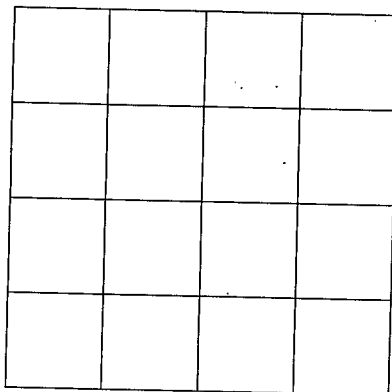

SECTION _____

Please indicate well location X.

ADDITIONAL INFORMATION

If more than one screen,
show location of each on sketch.