

Wayne

MISSISSIPPI BOARD OF WATER COMMISSIONERS

R3

11-66

WATER WELL DRILLERS LOG

Date: Nov, 1966, Driller: Peoples Drilling Co. County: Wayne

(Name)

(1) Owner of Land: Wilburn Coale (Name)

Rt 3 Warrabona (Address)

(2) Location: SE 1/4, SW 1/4, Sec. 10 T7R6

7 miles SW of Clara (distance) (direction) (Nearest Town)

(3) Topography: 4 lat to Hilly (Hilly) (Flat) (Level)

(4) Purpose of Well: Home (Domestic Irrigation Municipal, Industrial, Other)

Description & Color of Materials Sand, Clay, Red Clay, Shell, etc.

Thick-ness Feet

Depth Feet

White Clay	19	19
Yellow Sand	2	21
Yellow Sandy clay	19	40
Blue shale	44	84
Fine White Sand	11	95
Blue shale	74	173
Yellow sand	16	189

Information upon completion of well:

(1) Diameter 2 inches.

(2) Total Depth 189 feet.

(3) Water Level 103 feet below top of ground.

(4) Cased to 183', Size 2"

(5) Screen: Size 2", Length 6'


(6) Were any formations sealed against pollution?

yes, no.

If YES depth of formation

Why

Drillers Remarks:

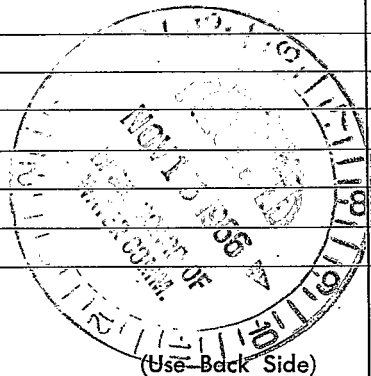

(Use-Back Side)

Well No.

