

RA

5-18-64

WATER WELL DRILLERS LOG

Date: May 18, 1964, Driller: Porter Drilling & Supply County Wayne
 (Name)


	Description & Color of Materials Sand, Clay, Red Clay, Shell, etc.	Thick- ness Feet	Depth Feet
(1) Owner of Land: <u>Hills Smith Jr.</u> (Name)			
<u>Rt 3 Magnolia Miss</u> (Address)	<u>red clay</u>	<u>6</u>	<u>6</u>
(2) Location: <u>SW 1/4, SW 1/4, Sec. 24 T. 2 R. 8</u>	<u>chalk</u>	<u>13</u>	<u>19</u>
<u>4</u> miles <u>SW</u> of <u>Clara</u> (distance) (direction) (Nearest Town)	<u>chalky sand</u>	<u>18</u>	<u>32</u>
(3) Topography: <u>Hilly</u> (Hilly) (Flat) (Level)	<u>sand</u>	<u>17</u>	<u>49</u>
(4) Purpose of Well: <u>domestic</u> (Domestic Irrigation Municipal, Industrial, Other)			

Information upon completion of well:

- (1) Diameter 2" inches.
- (2) Total Depth 45' feet.
- (3) Water Level 30' feet below top of ground.
- (4) Cased to 40', Size 2"
- (5) Screen: Size 1 1/4", Length 5'
Johnson 3.5
- (6) Were any formations sealed against pollution?
 yes, no.

If YES depth of formation _____
 Why _____

Drillers Remarks: _____

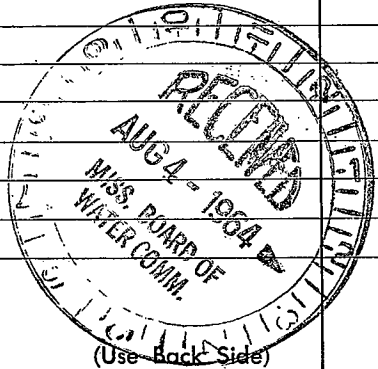

Well No. _____

