

**MISSISSIPPI
BOARD OF WATER COMMISSIONERS**
416 North State Street
Jackson, Mississippi 39201

WATER WELL DRILLERS LOG

Wayne
R5
4-67

April 3 1967 Boate Drilling & Logs Wayne
date well completed firm name county well located

LANDOWNER: Edith Mc Rae

description of formations encountered	from	to

At 3 Haynesboro Miss
(mailing address)

WELL LOCATION:
sec 24 T 7 N R 8 E
3 miles SW of Clara
(distance) (direction) (nearest town)

<u>red clay</u>	0	10
<u>chalk</u>	10	20
<u>fine sand</u>	20	26
<u>loose coarse sand</u>	26	34
<u>sand & chalk</u>	34	40
<u>stop on blue chalk</u>		


WELL PURPOSE: home
(home, irrigation, municipal, industrial)

- WELL COMPLETION DATA:
- (1) diameter (inches) 2"
 - (2) total depth (feet) 34'
 - (3) static water level (feet) 20' below above top of ground.
 - (4) casing steel, 28'
(material) (depth)
2" If telescope see back.
(size)
 - (5) screen 6', 28'
(length) (depth to top)
1/4", brass jacket
(size) (material)
 - (6) pump 1/2, 8
(HP) (yield gpm)
elec
(type power)
 - (7) electric log no
(yes or no)

(organization running log)

(8) how well bottom plugged
flush point

DRILLERS REMARKS:

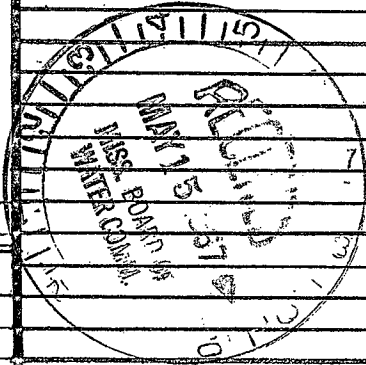

If well telescopes please sketch and show depths.

GROUND LEVEL

		X	
		X	

SECTION 24

Please indicate well location X.

ADDITIONAL INFORMATION

If more than one screen, show locations of each on sketch.