

Wayne
R9
9-18-68

MISSISSIPPI
BOARD OF WATER COMMISSIONERS
416 North State Street
Jackson, Mississippi 39201

CODER

WATER WELL DRILLERS LOG

CODER

date well completed Feb 18 1968 firm name Port Drillers Shop county well located Wayne

LANDOWNER: J. J. Ward
At 3 Magnolia Miss
(mailing address)

description of formations encountered	from	to
mantle	0	8
sh. s. s.	8	25
sh. l. s. sand	25	53
sh. s. s.	53	70
sh. s. s.	70	72
sh. s. s.	72	206
mantle sand	206	215

WELL LOCATION:
sec. 35 T 70 N R 9 E
7 miles SW of Clan
(distance) (direction) (nearest town)

WELL PURPOSE: home
(home, irrigation, municipal, industrial)

WELL COMPLETION DATA:

(1) diameter (inches) 2"

(2) total depth (feet) 215

(3) static water level (feet) 149 below above top of ground.

(4) casing steel 208'
(material) (depth)
2" if telescope see back.
(size)

(5) screen 5' 210
(length) (depth to top)
1/4" SS
(size) (material)

(6) pump 1/2 1/2
(HP) (yield gpm)
elec.
(type power)

(7) electric log no
(yes or no)
no
(organization running log)

(8) how well bottom plugged no

CODER


OCT 14 1968

MISS. BD. OF
WATER COMMISSIONERS

DRILLERS REMARKS:

If well telescopes please sketch and show depths.

GROUND LEVEL

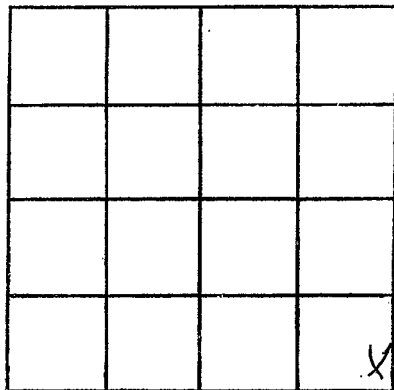

SECTION 35

Please indicate well location X.

ADDITIONAL INFORMATION

If more than one screen, show locations of each on sketch.