

CODED

MISSISSIPPI BOARD OF WATER COMMISSIONERS
416 North State Street
Jackson, Mississippi 39201

CODED

WATER WELL DRILLERS LOG

Wayne
TR 10
9-18-68

Sept 18, 1968 date well completed
Boster Drilling & Log firm name
Wayne county well located

LANDOWNER: J. H. Lindsey

description of formations encountered from to

Rt 3 Waynesboro Miss (mailing address)

red clay	0	8
sand & chert	8	21
blue chalk	21	40
chalk & sand streaks	40	63
blue chalk	63	93
fine sand & chalk	93	119
stopped on chalk		

WELL LOCATION:
sec 25 T-7 (N) R-8 E
5 miles SW of Clara (distance) (direction) (nearest town)

WELL PURPOSE: Home (home, irrigation, municipal, industrial)

WELL COMPLETION DATA:

- (1) diameter (inches) 2"
- (2) total depth (feet) 119'
- (3) static water level (feet) 48' below top of ground.
- (4) casing steel, 103' (material) (depth)
2" (size) If telescope see back.
- (5) screen 17' (length), 103' (depth to top)
90 gal 1/4" (size), brass jacket (material)
- (6) pump 1 (HP), 5 (yield gpm)
elec (type power)
- (7) electric log no (yes or no)

CODED

(organization running log)

(8) how well bottom plugged
flush point


DRILLERS REMARKS:

OCT 14 1968

MISS. BD. OF WATER COMM.

If well telescopes please sketch and show depths.

GROUND LEVEL

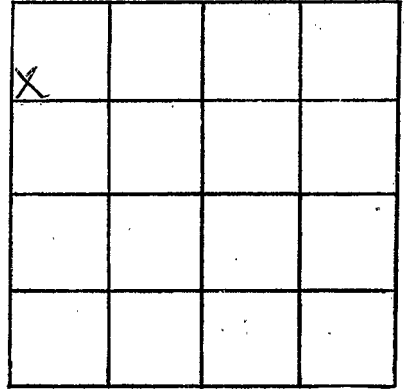

SECTION 25

Please indicate well location X.

ADDITIONAL INFORMATION

If more than one screen,
show locations of each on sketch.