

Wayne
R 11
9-13-68

MISSISSIPPI
BOARD OF WATER COMMISSIONERS
416 North State Street
Jackson, Mississippi 39201

CODED
CODED

CODED

WATER WELL DRILLERS LOG

9/13 1968 date well completed
Carris water well firm name
Wayne county well located

LANDOWNER: Pleasant Ridge
assembly of God Church
P.O. Box 323 (mailing address)

Description of formations encountered	from	to
Top soil	0	2
Red sandy clay	2	8
Pink & R. Rd. s. clay	8	29
Fine white sand	29	40
Coarse white sand	40	100


WELL LOCATION:
sec 25 T 70 N R 8 E S 1 W
9 miles S.W. of CLARA
(distance) (direction) (nearest town)

WELL PURPOSE: Home
(home, irrigation, municipal, industrial)

WELL COMPLETION DATA:

- (1) diameter (inches) 2" x 4"
- (2) total depth (feet) 51
- (3) static water level (feet) 29' below top of ground.
- (4) casing Galv 47 (material) (depth)
if telescope see back. (size)
- (5) screen 4' 47 (length) (depth to top)
2" PLASTIC (size) (material)
- (6) pump 1 9 (HP) (yield gpm)
Elect (type power)
- (7) electric log No (yes or no)
(organization running log)

CODED

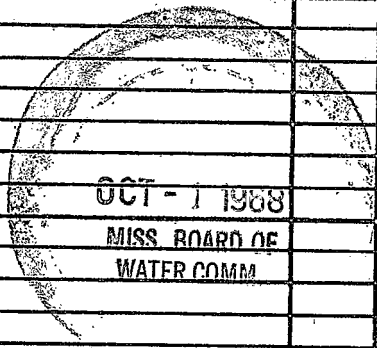


(8) how well bottom plugged Galv Plug

DRILLERS REMARKS: Drilled to 60' bottom 8' of sand would not pump

If well telescopes please sketch and show depths.

GROUND LEVEL

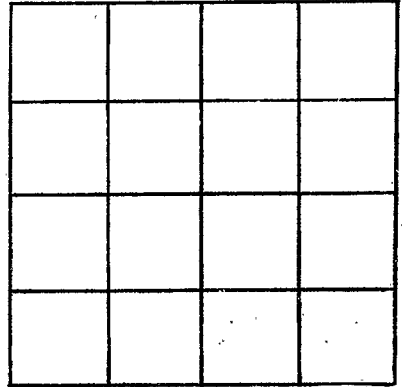

SECTION _____

Please indicate well location X.

ADDITIONAL INFORMATION

If more than one screen, show locations of each on sketch.