

Wayne  
R 12  
3-17-69

MISSISSIPPI  
BOARD OF WATER COMMISSIONERS  
416 North State Street  
Jackson, Mississippi 39201

CODED

WATER WELL DRILLERS LOG

March 17 1969 Paul Drilling & Log Wayne  
date well completed firm name county well located

LANDOWNER: Mr. Holberg description of formations encountered from to

P.O. Box 13 Magnolia Miss Chalk & sand 0 12  
(mailing address) course blue sand 12 46  
46 50

WELL LOCATION:  
sec 26 T 70 N R 3 E  
S W  
4 miles SW of Clare  
(distance) (direction) (nearest town)

WELL PURPOSE: home  
(home, irrigation, municipal, industrial)

WELL COMPLETION DATA:  
(1) diameter (inches) 2"  
(2) total depth (feet) 51

(3) static water level (feet) 31 (below/above top of ground)

(4) casing steel, 43'  
(material) (depth)  
2' If telescope see back.  
(size)

(5) screen 4', 47  
(length) (depth to top)  
1 1/2", solid SS  
(size) (material)

(6) pump 3/4, 6  
(HP) (yield gpm)  
elec.  
(type power)

(7) electric log no  
(yes or no)

(organization running log)

(8) how well bottom plugged solid sand

DRILLERS REMARKS:


CODED

MAR 24 1969

MISS. BD. OF  
WATER COMM.

If well telescopes please sketch and show depths.

GROUND LEVEL

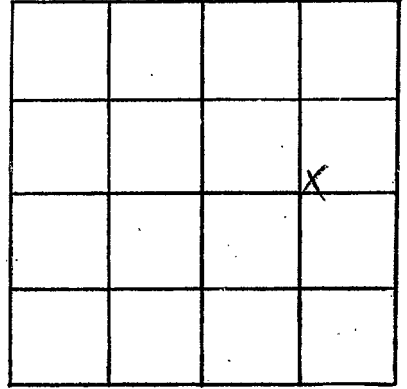

SECTION 26

Please indicate well location X.

ADDITIONAL INFORMATION

If more than one screen, show locations of each on sketch.