

**MISSISSIPPI
BOARD OF WATER COMMISSIONERS**
416 North State Street
Jackson, Mississippi 39201

CODED

WATER WELL DRILLERS LOG

WAYNE
R 13
7-21-69

July 21 1969 Robert Dillingham Wayne
 date well completed firm name county well located


LANDOWNER:	description of formations encountered	from	to
<u>White Handerson</u> <u>206 Monroe St.</u> <u>Waynesboro Miss</u> (mailing address)		<u>red clay</u> <u>sand & clack</u> <u>red sand</u>	<u>0</u> <u>30</u> <u>30</u>
WELL LOCATION: sec <u>2</u> T <u>70</u> N R <u>8</u> E S W (W) <u>2</u> miles SW of <u>Albion</u> (distance) (direction) (nearest town)	<u>stone to shell in</u> <u>red sand</u>		
WELL PURPOSE: (home, irrigation, municipal, industrial)	<u>water for 1 in with</u>		
WELL COMPLETION DATA:	<u>driller 1 1/2" 1/2" change</u> <u>pipe</u>		
(1) diameter (inches) <u>2"</u>			
(2) total depth (feet) <u>57</u>			
(3) static water level (feet) <u>50</u> below top of ground.			
(4) casing <u>steel</u> <u>50 1/2</u> (material) (depth)			
<u>2"</u> (size) if telescope see back.			
(5) screen <u>6'</u> <u>52'</u> (length) (depth to top)			
<u>1 1/2"</u> <u>hot s.s.</u> (size) (material)			
(6) pump <u>2 1/2</u> <u>6</u> (HP) (yield gpm)			
<u>elec</u> (type power)			
(7) electric log _____ (yes or no)			
_____ (organization running log)			
(8) how well bottom plugged <u>plugged</u>			
DRILLERS REMARKS:			

AUG 15 1969

MISS. Bd. of
WATER COMMISSIONERS

If well telescopes please sketch and show depths.

GROUND LEVEL

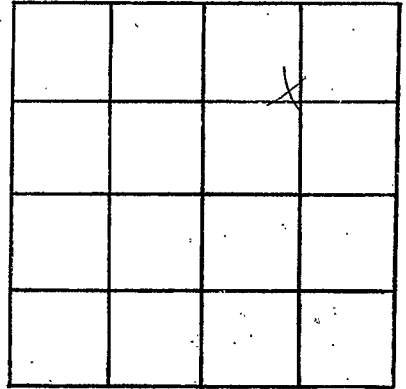

SECTION 31

Please indicate well location X.

ADDITIONAL INFORMATION

If more than one screen,
show locations of each on sketch.