

Wayne  
 8 R16  
 9-68

MISSISSIPPI  
 BOARD OF WATER COMMISSIONERS  
 416 North State Street  
 Jackson, Mississippi 39201

CODED

WATER WELL DRILLERS LOG

Sept 13 1968 date well completed  
 Route Drilling Co firm name  
 Wayne county well located

LANDOWNER: Wayne and Betty

description of formations encountered	from	to
red clay	0	6
red clay	6	32
blue clay	32	127
blue clay and sand	127	206
blue sand & chalk	206	225
blue sand and chalk	225	232
blue chalk	232	245
red sand	245	252
blue chalk	252	12

Box 3 Hurricane Miss.  
 (mailing address)

WELL LOCATION:  
 sec. 25 T 7 N R 2 E  
 S W  
 (distance) miles (direction) of (nearest town)

WELL PURPOSE:  
 (home, irrigation, municipal, industrial)

WELL COMPLETION DATA:

- (1) diameter (inches) 9"
- (2) total depth (feet) 232
- (3) static water level (feet) 112 below top of ground.
- (4) casing 231 (material) (depth)  
 2" (size) if telescope see back.
- (5) screen 4' 236 (length) (depth to top)  
 1/2" (size) (material)
- (6) pump 3/4 HP 9 1/2 (yield gpm)


(type power)

(7) electric log (yes or no)  
 (organization running log)

(8) how well bottom plugged


DRILLERS REMARKS:

5' 1/2" by 1/2" on or near  
 friction with packer  
 Cylindrical friction at  
 145' with packer below  
 in hole bed

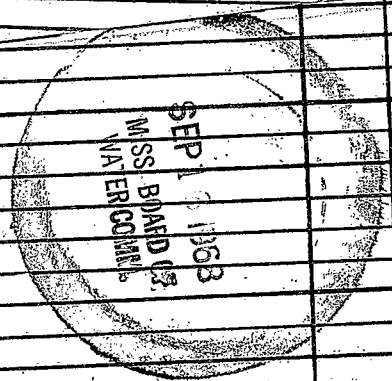

If well telescopes please sketch and show depths.

GROUND LEVEL

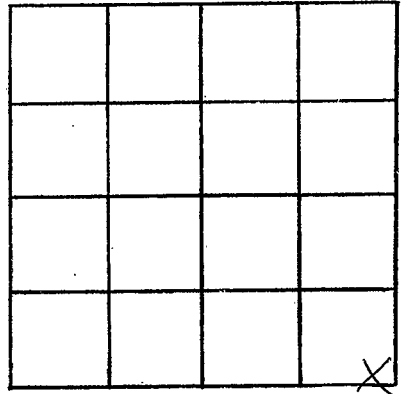

SECTION 35

Please indicate well location X.

ADDITIONAL INFORMATION

If more than one screen,  
show locations of each on sketch.