

MISSISSIPPI  
BOARD OF WATER COMMISSIONERS  
416 North State Street  
Jackson, Mississippi 39201

**CODED**

WATER WELL DRILLERS LOG

Wayne  
R 18  
6-70

June 1970 Peoples Drilling Co Wayne  
date well completed firm name county well located

LANDOWNER: G. M. Sanders  
806 Wayne St.  
Waynesboro, Miss.  
(mailing address)

WELL LOCATION:  
sec 31 T 7 N R 8  
6 miles SE of Shenandoah  
(distance) (direction) (nearest town)

WELL PURPOSE: Fish Pond  
(home, irrigation, municipal, industrial)

- WELL COMPLETION DATA:
- (1) diameter (inches) 4
  - (2) total depth (feet) 195
  - (3) static water level (feet) 36 <sup>below</sup> <sub>above</sub> top of ground.
  - (4) casing Iron, 190,  
(material) (depth)  
4"  
(size) if telescope see back.
  - (5) screen 5', 190  
(length) (depth to top)  
2", Stainless Steel  
(size) (material)
  - (6) pump 3 HP, 40-60  
(HP) (yield gpm)  
Electric Air Comp.  
(type power)
  - (7) electric log No  
(yes or no)

(organization running log)  
  
(8) how well bottom plugged Back  
Wash barrel

description of formations encountered	from	to
<u>Yellow Sandy clay</u>	<u>0</u>	<u>17</u>
<u>Yellow Sand</u>	<u>17</u>	<u>36</u>
<u>White Clay</u>	<u>36</u>	<u>53</u>
<u>Yellow Sand</u>	<u>53</u>	<u>63</u>
<u>Blue Sandy Clay + Small Sand streaks</u>	<u>63</u>	<u>162</u>
<u>Coarse Multi-colored Sand Pea Gravel</u>	<u>162</u>	<u>195</u>

**CODED**


JUL 2 1970

DRILLERS REMARKS:

MISS. BD. OF  
WATER COMM.

If well telescopes please sketch and show depths.

GROUND LEVEL

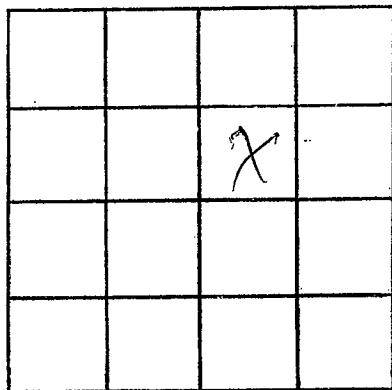

SECTION 31

Please indicate well location X.

ADDITIONAL INFORMATION

If more than one screen, show locations of each on sketch.