

MISSISSIPPI  
BOARD OF WATER COMMISSIONERS.  
416 North State Street  
Jackson, Mississippi 39201

**CODED**

**WATER WELL DRILLERS LOG**

Wayne  
R 19  
7-2-70

July 7 1970 Robert Drilling Co Wayne  
date well completed firm name county well located

LANDOWNER: J. S. Hart Jr.  
213 Manselboro Miss  
(mailing address)

WELL LOCATION:  
sec 26 T 70 N R 2 E  
5 miles SW of Clara  
(distance) (direction) (nearest town)

WELL PURPOSE: home  
(home, irrigation, municipal, industrial)

- WELL COMPLETION DATA:
- (1) diameter (inches) 2"
  - (2) total depth (feet) 43'
  - (3) static water level (feet) 17' (below above top of ground)
  - (4) casing steel 37'  
(material) (depth)  
2" If telescope see back.  
(size)
  - (5) screen 5' 38'  
(length) (depth to top)  
1 1/4" galv. S.S.  
(size) (material)
  - (6) pump 3/4 9  
(HP) (yield gpm)  
elec  
(type power)
  - (7) electric log no  
(yes or no)
- (organization running log)

(8) how well bottom plugged  
flush from top


DRILLERS REMARKS:

description of formations encountered	from	to
<u>red clay</u>	<u>0</u>	<u>14</u>
<u>fine sand &amp; shells</u>	<u>14</u>	<u>43</u>
<u>stop on blocks</u>		
<u>5' 1/4" to slot S.S. with</u>		
<u>2' 1/4" log pipe section</u>		
<u>with packer</u>		
<u>21' 1/4" dng pipe</u>		
<b>CODED</b>		

AUG 11 1970

If well telescopes please sketch and show depths.

GROUND LEVEL

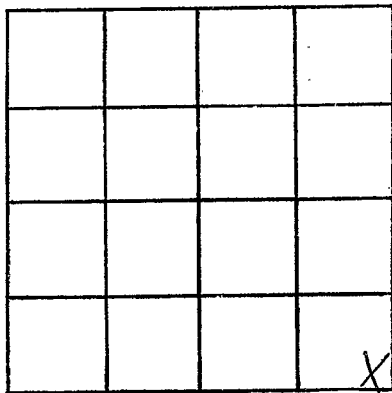

SECTION 26

Please indicate well location X.

ADDITIONAL INFORMATION

If more than one screen,  
show locations of each on sketch.