

WAYNE
R 20
9-2-71

MISSISSIPPI
BOARD OF WATER COMMISSIONERS
416 North State Street
Jackson, Mississippi 39201

WATER WELL DRILLERS LOG

1971 *Paul Dick* firm name *Paul Dick* county well located **COPIED**

LANDOWNER: *Shelley Waters*
213 Magnolia
(mailing address)

description of formations encountered	from	to
<i>red clay & chalk</i>	<i>0</i>	<i>31</i>
<i>blue chalk</i>	<i>31</i>	<i>117</i>
<i>red & chalk</i>	<i>117</i>	<i>177</i>
<i>red sand</i>	<i>177</i>	<i>190</i>
<i>stagnant chalk</i>		

WELL LOCATION:
sec. *24* T. *70* N. R. *8* E. S. *3*
3 miles *SW* of *Clayton*
(distance) (direction) (nearest town)

WELL PURPOSE: *Home*
(home, irrigation, municipal, industrial)

- WELL COMPLETION DATA:
- (1) diameter (inches) *2"*
 - (2) total depth (feet) *194'*
 - (3) static water level (feet) *105'* below above top of ground.
 - (4) casing *steel*, *190'*
(material), (depth)
 - 2"*
(size) If telescope see back.
 - (5) screen *1"*, *180'*
(length), (depth to top)
 - 1"*, *brckt S.S.*
(size), (material)
 - (6) pump *3/4* - *3 1/2*
(HP), (yield gpm)
 - elec*
(type power)
 - (7) electric log *no*
(yes or no)
 - (organization running log)
 - (8) how well bottom plugged *filled*

4' to brckt S.S. to 1'
in with
cy. brckt
available as usual

COPIED


OCT 6 1971

DRILLERS REMARKS:

MISS. DEP. OF
WATER COMMISSIONERS

If well telescopes please sketch and show depths.

GROUND LEVEL

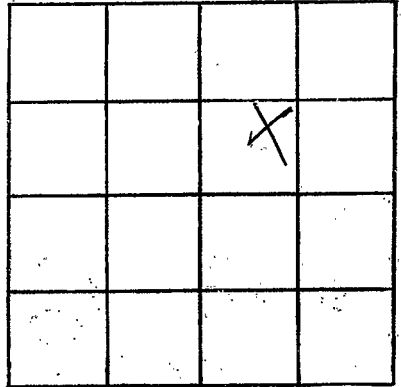

SECTION 24

Please indicate well location X.

ADDITIONAL INFORMATION

If more than one screen, show locations of each on sketch.