

Wayne
R 21
1-29-72

MISSISSIPPI
BOARD OF WATER COMMISSIONERS
416 North State Street
Jackson, Mississippi 39201

FEB 10 1972

WATER WELL DRILLERS LOG

CODED
Wayne


1-29-1972 date well completed 72 Risen Water Well Co. firm name Wayne county well located

LANDOWNER:	description of formations encountered	from	to
C.H. Dyess Rt 2 Waynesboro, Miss (mailing address)			
WELL LOCATION:			
sec. 2 T 7 ^(N) / _S R 8 ^(E) / _W 2 miles West of Waynesboro (distance) (direction) (nearest town)			
WELL PURPOSE: None (home, irrigation, municipal, industrial)			
WELL COMPLETION DATA:			
(1) diameter (inches) 3"			
(2) total depth (feet) 19'			
(3) static water level (feet) 6' below top of ground.			
(4) casing 1 1/2" (material) 16' (depth)			
(size) If telescope see back.			
(5) screen 3' (length) 19' (depth to top)			
1 1/4" Brass lined drive pin (size) (material)			
(6) pump 1/2 (HP) 11 (yield gpm)			
Electric (type power)			
(7) electric log no (yes or no)			
(organization running log)			
(8) how well bottom plugged drive - point			
DRILLERS REMARKS: Good			

CODED

If well telescopes please sketch and show depths.

GROUND LEVEL

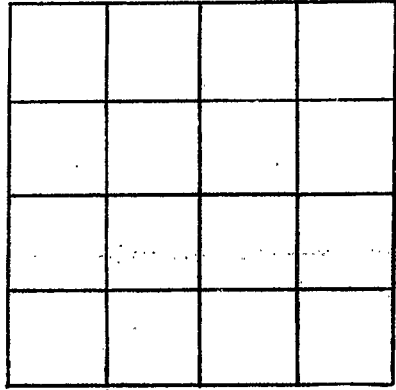

SECTION _____

Please indicate well location X.

ADDITIONAL INFORMATION

If more than one screen,
show locations of each on sketch.