

Wayne
R 22
8-14-72

MISSISSIPPI
BOARD OF WATER COMMISSIONERS
416 North State Street
Jackson, Mississippi 39201

CODED

WATER WELL DRILLERS LOG

Aug 14 1972 date well completed
Porter Drilling & Log firm name
Wayne county well located

LANDOWNER:	description of formations encountered	from	to
Chas Kennell	rest clay	0	10
213 Hayesboro Miss (mailing address)	Chalk	10	20
	fine sand & chalk	20	76
	Lead sand	76	80
	Chalk to sand	80	90
	blue chalk	90	129
	fine sand	129	136
	blue chalk	136	162
	sand & chalk	162	166
	blue chalk	166	175
	fine sand & chalk	175	180
	fine to med sand	180	243
	stopout on chalk		
	5' 1/4" belst SS with		
	2' 1/4" large pipe bent		
	in with packer		
	126' to change pipe		
	CODED		

WELL LOCATION:

sec. 35 T 70 N R 8 E
5 miles SW of Clava (nearest town)

WELL PURPOSE: Home (home, irrigation, municipal, industrial)

WELL COMPLETION DATA:

- (1) diameter (inches) 2"
- (2) total depth (feet) 243'
- (3) static water level (feet) 110' below top of ground
- (4) casing steel 239' (material) (depth) 2" (size) If telescope see back.
- (5) screen 5' 239' (length) (depth to top) 1/4" belst 55. (size) (material)
- (6) pump 2 (HP) 9 (yield gpm) elec (type power)
- (7) electric log no (yes or no)


(organization running log)

(8) how well bottom plugged
filled ground

DRILLERS REMARKS:

If well telescopes please sketch and show depths.

GROUND LEVEL

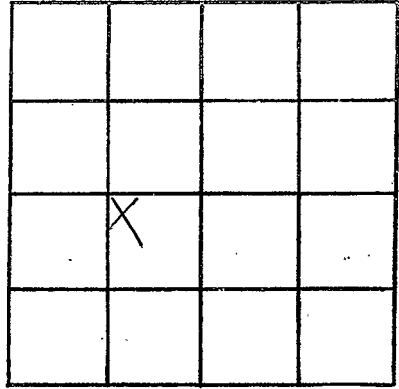

SECTION 35

Please indicate well location X.

ADDITIONAL INFORMATION

If more than one screen, show locations of each on sketch.