

BOARD OF WATER COMMISSIONERS

416 North State Street  
Jackson, Mississippi 39201

**CODED**

WAYNE

R 23

7-6-73

WATER WELL DRILLERS LOG

July 6 1973 Boater Drilling & Log Wayne  
date well completed firm name county well located

LANDOWNER: James H. Howell

description of formations encountered from to

Box 321 Cypressboro, Miss  
(mailing address)

rest clay & sand 0 16  
rest sand 16 40  
stagnant on chalk

WELL LOCATION:

sec. 35 T. 7 N. R. 8 E  
5 miles SW of Clava  
(distance) (direction) (nearest town)

3.5' 1" plastic drop pipe

WELL PURPOSE: drone  
(home, irrigation, municipal, industrial)

sweet sand perched

WELL COMPLETION DATA:

- (1) diameter (inches) 2"
- (2) total depth (feet) 40'
- (3) static water level (feet) 22 (below/above top of ground)
- (4) casing plastic, 36'  
(material) (depth)  
2" If telescope see back.  
(size)
- (5) screen 4', 36  
(length) (depth to top)  
2", plastic  
(size) (material)
- (6) pump 1, 10  
(HP) (yield gpm)  
elec.  
(type power)
- (7) electric log no  
(yes or no)  
  
(organization running log)
- (8) how well bottom plugged  
backwash valve


**CODED**

DRILLERS REMARKS:

JUL 31 1973

If well telescopes please sketch and show depths.

GROUND LEVEL

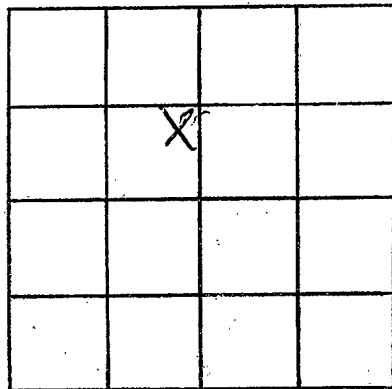

SECTION 35

Please indicate well location X.

ADDITIONAL INFORMATION

If more than one screen,  
show locations of each on sketch.