

WAYNE
R 24
1-16-74

MISSISSIPPI
OF WATER COMMISSIONERS
416 North State Street
Jackson, Mississippi 39201

CODED

WATER WELL DRILLERS LOG

Jan 16 1974 Ray Uwert water wells wayne
date well completed firm name county well located

LANDOWNER: Luke Smith
Rt 2 waynesboro
(mailing address)

description of formations encountered	from	to
clay	0	8
hardy clay	8	30
clay	30	130
fine sand	130	145
clay	145	190
sand	190	215

WELL LOCATION:
sec 32 T 7 N R 8 E
10 miles S E of Clora
(distance) (direction) (nearest town)

WELL PURPOSE: home
(home, irrigation, municipal, industrial)

- WELL COMPLETION DATA:
- (1) diameter (inches) 2 1/2
 - (2) total depth (feet) 215
 - (3) static water level (feet) 94 below above top of ground.
 - (4) casing galv 210
(material) (depth)
if telescope see back.
(size)
 - (5) screen 5 210
(length) (depth to top)
1/4 st steel
(size) (material)
 - (6) pump 1 8
(HP) (yield gpm)
R&A
(type power)
 - (7) electric log no
(yes or no)
(organization running log)
 - (8) how well bottom plugged washed


CODED

DRILLERS REMARKS:

RECORDED
INDEXED
JAN 28 1974

If well telescopes please sketch and show depths.

GROUND LEVEL

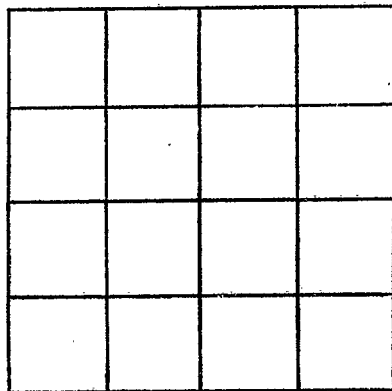

SECTION _____

Please indicate well location X.

ADDITIONAL INFORMATION

If more than one screen,
show locations of each on sketch.