

CODED

Wayne
R 25
5-17-75

MISSISSIPPI
BOARD OF WATER COMMISSIONERS
416 North State Street
Jackson, Mississippi 39201

WATER WELL DRILLERS LOG

May 17, 1975 19 McILWAIN WATER WELL SERVICE Wayne
date well completed RT. Box 37 county well located
WAYNESBORO, MISS. 39387

LANDOWNER: ~~Mr~~

MR. CHARLES HENDERSON
Rt 3 Waynesboro, Miss.
(mailing address)

description of formations encountered

from to

Red Clay	0	7
Mixed Clay	7	15
grey clay	15	53
Blue Clay	53	78
Brown Clay	78	95
grey clay	95	105
Mixed Clay	105	200
fine sand	200	225
med sand	225	242

WELL LOCATION:

sec 34 T 7 N R 8 E 134
8 miles SW of CLARA
(distance) (direction) (nearest town)

WELL PURPOSE: HOME
(home, irrigation, municipal, industrial)

WELL COMPLETION DATA:

- (1) diameter (inches) 2"
- (2) total depth (feet) 242'
- (3) static water level (feet) 113 below top of ground.
- (4) casing PVC 232' (material) (depth)
2" (size) if telescope see back.
- (5) screen 10' 232 (length) (depth to top)
2" PVC .008 Slot (size) (material)
- (6) pump 2 5 (HP) (yield gpm)
220 AC (type power)
- (7) electric log no (yes or no)

(organization running log)

(8) how well bottom plugged


DRILLERS REMARKS:

DEC 15 1975

MISS. BD. OF WATER

If well telescopes please sketch and show depths.

GROUND LEVEL

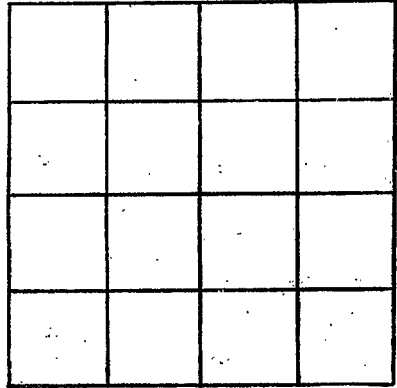

SECTION _____

Please indicate well location X.

ADDITIONAL INFORMATION

If more than one screen, show locations of each on sketch.