

CODED

Wayne  
R 26  
5-19-75

MISSISSIPPI  
BOARD OF WATER COMMISSIONERS  
416 North State Street  
Jackson, Mississippi 39201

WATER WELL DRILLERS LOG


McILWAIN WATER WELL SERVICE Wayne  
date well completed 19 May 19, 1975 RT. firm name BOX 37 county well located Wayne  
WAYNESBORO, MISS 39367

| LANDOWNER:   | description of formations encountered | from      | to        |
|--|---------------------------------------|-----------|-----------|
| <u>MR. FAGAN COOLEY</u><br><u>Rt 3 WAYNESBORO, MISS</u><br>(mailing address)   |                                       |           |           |
|  | <u>Mixed Clay</u>                     | <u>5</u>  | <u>12</u> |
|  | <u>Sand + Clay</u>                    | <u>12</u> | <u>18</u> |
|  | <u>Sand</u>                           | <u>18</u> | <u>32</u> |
| WELL LOCATION:<br>sec. <u>22</u> T. <u>7</u> N R. <u>8</u> <sup>13φ</sup><br><u>7</u> miles <u>SW</u> of <u>CLARA</u><br>(distance) (direction) (nearest town)   |                                       |           |           |
| WELL PURPOSE: <u>HOME</u><br>(home, irrigation, municipal, industrial)   |                                       |           |           |
| WELL COMPLETION DATA:<br>(1) diameter (inches) <u>2"</u><br>(2) total depth (feet) <u>32'</u><br>(3) static water level (feet) <u>16'</u> <sup>below</sup> <sub>above</sub> top of ground.<br>(4) casing <u>PVC</u> <u>27'</u><br>(material) (depth)<br><u>2"</u><br>(size) if telescope see back.<br>(5) screen <u>5'</u> <u>27'</u><br>(length) (depth to top)<br><u>2"</u> <u>PVC .008 Slot</u><br>(size) (material)<br>(6) pump <u>1</u> <u>12</u><br>(HP) (yield gpm)<br><u>220 AC</u><br>(type power)<br>(7) electric log <u>NO</u><br>(yes or no)<br>_____<br>(organization running log)<br>(8) how well bottom plugged _____ |                                       |           |           |
| DRILLERS REMARKS: _____  |                                       |           |           |

RECEIVED  
MAY 18 1975  
MISS. Bd. OF WATER COMMISSIONERS

If well telescopes please sketch and show depths.

GROUND LEVEL

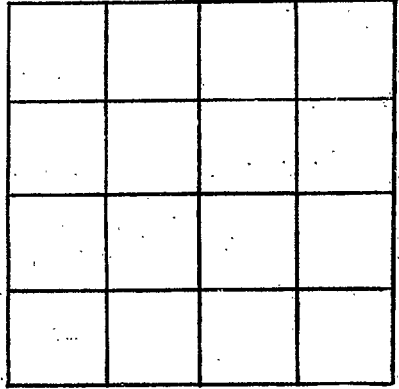

SECTION \_\_\_\_\_

Please indicate well location X.

ADDITIONAL INFORMATION

If more than one screen, show locations of each on sketch.