

CODED

WAYNE  
R 27  
8-11-75

MISSISSIPPI  
BOARD OF WATER COMMISSIONERS  
416 North State Street  
Jackson, Mississippi 39201

13P WATER WELL DRILLERS LOG

AUG 11, 1975  
date well completed

19 McILWAIN WATER WELL SERVICE

WAYNE

RI firm name 37  
WAYNESBORO MISS 39367

county well located

LANDOWNER:  
PLEASANT RIDGE ASSEMBLY OF GOD  
CHURCH  
Route 3 Waynesboro, Miss  
(mailing address)

description of formations encountered	from	to
RED CLAY	0	4
MIXED CLAY	4	12
PINK CLAY	12	25
BLACK CLAY	25	35
SAND + CLAY	35	43
COARSE SAND	43	52

WELL LOCATION:

sec. 25 T 7 N R 8 E  
5 miles SW of CLARA  
(distance) (direction) (nearest town)

WELL PURPOSE: CHURCH  
(home, irrigation, municipal, industrial)

WELL COMPLETION DATA:

- (1) diameter (inches) 2"
- (2) total depth (feet) 52'
- (3) static water level (feet) 26' below top of ground.
- (4) casing PVC 47' (material) (depth)  
2" (size) If telescope see back.
- (5) screen 5' 47' (length) (depth to top)  
2" PVC .008 (size) (material)
- (6) pump 1 10 (HP) (yield gpm)  
220 AC (type power)
- (7) electric log NO (yes or no)

(organization running log)

(8) how well bottom plugged


DRILLERS REMARKS:

IDENTIFIED BY  
KSL  
AUG 10 1975

MISS. BD. OF WATER COM.

If well telescopes please sketch and show depths.

GROUND LEVEL

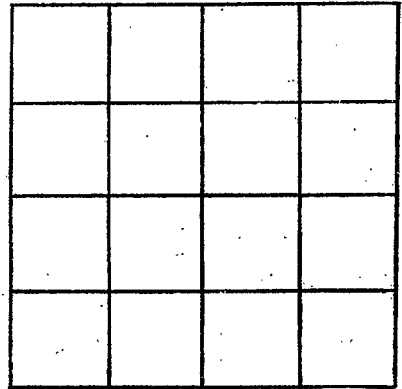

SECTION \_\_\_\_\_

Please indicate well location X.

ADDITIONAL INFORMATION

If more than one screen, show locations of each on sketch.