

MISSISSIPPI DEPARTMENT OF NATURAL RESOURCES

Bureau of Land and Water Resources

Southport Mall

P.O. Box 10631

Jackson, Mississippi 39209

WATER WELL DRILLERS LOG

WAYNE
R 29
294D

Coled

11-11 19 87 Morphis Bro. Wayne
date well completed firm name county well located

LANDOWNER: Justiss Oil
P.O. Box 1385
Jena, La 71342
(mailing address)

description of formations encountered	from	to
White Clay	0	20
White Clay & Sand	20	40
Red Clay & Sand	40	60
Red Clay & Sand	60	140
White Sand Med Course	140	160
11 11 11	160	180
Sand	180	183
Clay	183	185

WELL LOCATION:
sec. 4 T. 7 (N) R. 8 (E)
S (W)
11 miles South of Clara
(distance) (direction) (nearest town)


WELL PURPOSE:
(home, irrigation, municipal, industrial)

- WELL COMPLETION DATA:
- (1) diameter (inches) 7 7/8
 - (2) total depth (feet) 185
 - (3) static water level (feet) 55 ^{below} above top of ground.
 - (4) casing PVC, 165,
(material) (depth)
4"
(size) if telescope see back.
 - (5) screen 20', 163
(length) (depth to top)
4", PVC, .025
(size) (material)
 - (6) pump 3, 55
(HP) (yield gpm)
Subm.
(type power)
 - (7) electric log NO
(yes or no)

(organization running log)

(8) how well bottom plugged Back wash
Valve

DRILLERS REMARKS: Well aired
80 to 100 G.P.M.

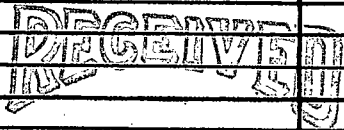

NOV 30 1987


Department of Natural Resources
Bureau of Land & Water Resources

If well telescopes please sketch and show depths.

GROUND LEVEL

165
Screen
1025
20 FT PUC

185' Total
4" PUC

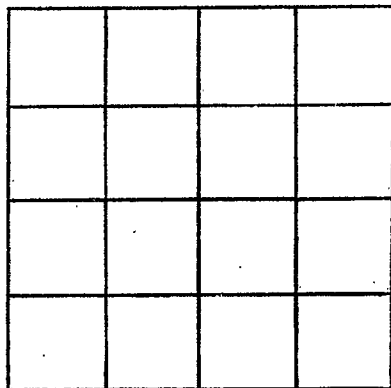

SECTION _____

Please indicate well location X.

ADDITIONAL INFORMATION

Multiple horizontal lines for providing additional information.

If more than one screen, show locations of each on sketch.