

WAYNE
R 2000
12-10-76

MISSISSIPPI
BOARD OF WATER COMMISSIONERS
416 North State Street
Jackson, Mississippi 39201

WATER WELL DRILLERS LOG

12-10-76 date well completed 13¢ ZL CARR well serv firm name WAYNE county well located

LANDOWNER: Huey PERRY

description of formations encountered	from	to
Top Soil	0	2
yellow SAND	2	12
yellow+white clay	12	19
Bluish clay	19	30
white+pink clay	30	35
white CREAMY clay	35	45
DARK Blue clay	45	50
GRAY clay	50	58
Blue+GRAY clay	58	75
yellow clay	75	78
Brown Rocks of lime		
white SA	78	88
white clay	88	90
Fine white sand	90	98
Med white sand	98	105
Blue clay	105	107

(mailing address)

WELL LOCATION:

sec. 34 T. 17 N. R. 3 E
5 miles SSW of CLARK
(distance) (direction) (nearest town)

WELL PURPOSE: Home
(home, irrigation, municipal, industrial)

WELL COMPLETION DATA:

- (1) diameter (inches) 2"
- (2) total depth (feet) 104
- (3) static water level (feet) 25 below top of ground.

(4) casing PVC, 100' (material) (depth)

(size) If telescope see back.

(5) screen 4' (length), 100' (depth to top)

1/4" SS. 7.56 + smooth (size) (material)

(6) pump 3/4 HP, 4 (yield gpm)

Elect (type power)

(7) electric log No (yes or no)

(organization running log)

(8) how well bottom plugged 1/4" GAV plug

DRILLERS REMARKS:


RECEIVED

FEB 16 1971

MISS. Bd. OF WATER COMMISSIONERS

If well telescopes please sketch and show depths.

GROUND LEVEL

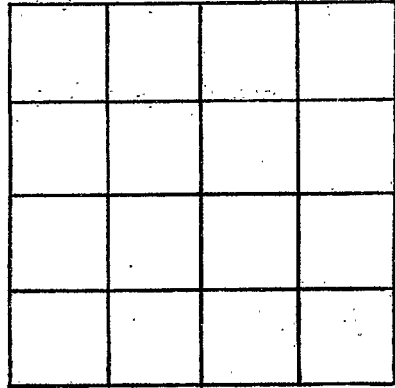

SECTION _____

Please indicate well location X.

ADDITIONAL INFORMATION

If more than one screen, show locations of each on sketch.