

**WAYNE**  
**R 2003**  
**2/23/77**

**MISSISSIPPI**  
**BOARD OF WATER COMMISSIONERS**  
 416 North State Street  
 Jackson, Mississippi 39201

**WATER WELL DRILLERS LOG**

**13φ**  
 date well completed Feb 23 1977 Pinter Drilling firm name Wayne county well located

LANDOWNER: <u>Mark B. Conley</u>	description of formations encountered	from	to
<u>Box 3 Wayneboro</u> (mailing address)			
<b>WELL LOCATION:</b> sec. <u>17</u> T. <u>70</u> N. R. <u>8</u> E. <u>W</u> <u>7</u> miles <u>W</u> of <u>Clara</u> (distance) (direction) (nearest town)	<u>clay</u> <u>sand</u> <u>sand &amp; clay</u> <u>stratified clay</u>	<u>0</u>	<u>13</u> <u>20</u> <u>23</u>
<b>WELL PURPOSE:</b> <u>Home</u> (home, irrigation, municipal, industrial)	<u>shallow well pump</u> <u>no drop pipe</u>		
<b>WELL COMPLETION DATA:</b>			
(1) diameter (inches) <u>2'</u>			
(2) total depth (feet) <u>21</u>			
(3) static water level (feet) <u>15</u> <u>below</u> <u>above</u> top of ground.			
(4) casing <u>PVC</u> , <u>18'</u> (material) (depth) <u>2'</u> If telescope see back. (size)			
(5) screen <u>3'</u> , <u>18'</u> (length) (depth to top) <u>1 1/4" galv S.S.</u> (size) (material)			
(6) pump <u>1/2</u> , <u>3</u> (HP) (yield gpm) <u>elec.</u> (type power)			
(7) electric log <u>no</u> (yes or no)  (organization running log)			
(8) how well bottom plugged <u>flush ground</u>			
<b>DRILLERS REMARKS:</b>			


**RECEIVED**

APR 6 1977

**MISS. Bd. OF WATER COMMISSIONERS**

If well telescopes please sketch and show depths.

GROUND LEVEL

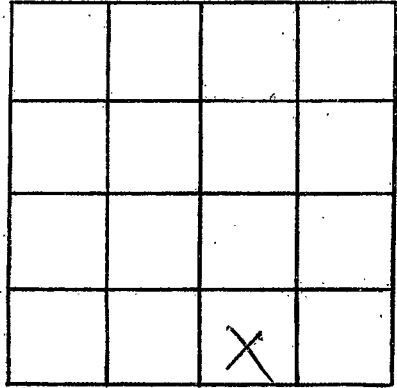

SECTION

17

Please indicate well location X.

ADDITIONAL INFORMATION

If more than one screen,  
show locations of each on sketch.