

**WAYNE**  
 R ~~2004~~  
 2/25/77

MISSISSIPPI  
 BOARD OF WATER COMMISSIONERS  
 416 North State Street  
 Jackson, Mississippi 39201

13¢  
 WATER WELL DRILLERS LOG

Feb. 25 1977 Porter Drilling Wayne  
 date well completed firm name county well located

LANDOWNER: <u>J. L. Conley</u>	description of formations encountered	from	to
<u>213 Wayneboro</u> (mailing address)			
WELL LOCATION: sec. <u>17</u> T. <u>70</u> N. R. <u>8</u> E. S. <u>W</u> of <u>Clara</u> (distance) miles (direction) or (nearest town)	<u>19' 1" P.V.C. pipe</u>		
WELL PURPOSE: <u>Home</u> (home, irrigation, municipal, industrial)	<u>pipe well 5' 1" P.V.C.</u> <u>haul pipe below jet</u>		
WELL COMPLETION DATA: (1) diameter (inches) <u>2"</u>			
(2) total depth (feet) <u>25</u>			
(3) static water level (feet) <u>18'</u> below above top of ground.			
(4) casing <u>P.V.C. 20'</u> (material) (depth) <u>2'</u> if telescope see back. (size)			
(5) screen <u>5' 20'</u> (length) (depth to top) <u>2" Galv. P.V.C.</u> (size) (material)			
(6) pump <u>1</u> <u>3-2</u> (HP) (yield gpm) <u>elec.</u> (type power)			
(7) electric log <u>no</u> (yes or no) <u>(organization running log)</u>			
(8) how well bottom plugged <u>plugged</u>			
DRILLERS REMARKS:			


RECEIVED

APR 6 1977

MISS. BO. OF WATER COMMISSIONERS

If well telescopes please sketch and show depths.

GROUND LEVEL

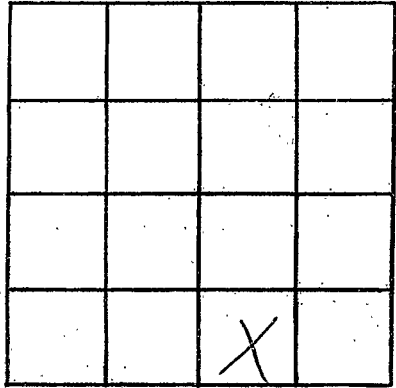

SECTION 17

Please indicate well location X.

ADDITIONAL INFORMATION

If more than one screen,  
show locations of each on sketch.