

WAYNE
 R2005
 6-21-78

MISSISSIPPI
 BOARD OF WATER COMMISSIONERS
 416 North State Street
 Jackson, Mississippi 39201

WATER WELL DRILLERS LOG

JUNE 21 1978 date well completed
 RAINWAIN WATER WELL SERVICE WAYNE
 RT#2, BOX 3A WAYNESBORO, MISS. 39367 county well located

LANDOWNER:
 Tommy MASON
 CLARA, Ms.
 (mailing address)

WELL LOCATION:
 sec. 15 T. 7 N R. 8 E
 6 miles SW of CLARA
 (distance) (direction) (nearest town)

WELL PURPOSE: Home
 (home, irrigation, municipal, industrial)

- WELL COMPLETION DATA:
- (1) diameter (inches) 2"
 - (2) total depth (feet) 40'
 - (3) static water level (feet) 17' below top of ground.
 - (4) casing PVC 35' (material) (depth)
 2" (size) if telescope see back.
 - (5) screen 5' 35' (length) (depth to top)
 2" PVC .008 (size) (material)
 - (6) pump 1 11 (HP) (yield gpm)
 220 AC (type power)
 - (7) electric log No (yes or no)
 - (organization running log)
 - (8) how well bottom plugged

description of formations encountered	from	to
Red Sandy Clay	0	5
Mixed Clay	5	10
Grey Clay	10	21
Fine Sand	21	25
Clay	23	32
Sand (Med)	32	40


RECEIVED
 AUG 11 1978

MISS. BD. OF WATER COMMISSIONERS

DRILLERS REMARKS:

If well telescopes please sketch and show depths.

GROUND LEVEL

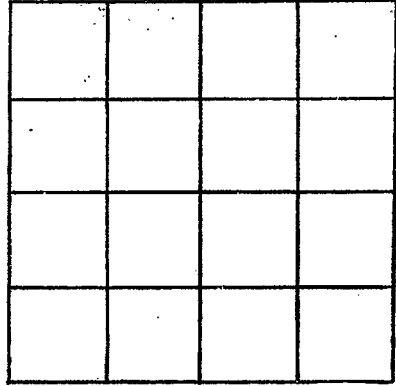

SECTION _____

Please indicate well location X.

ADDITIONAL INFORMATION

If more than one screen,
show locations of each on sketch.