

WAYNE

R *W*

8-11-78

MISSISSIPPI
BOARD OF WATER COMMISSIONERS
416 North State Street
Jackson, Mississippi 39201

WATER WELL DRILLERS LOG

Aug 11

1978

MILWAIN WATER WELL SERVICE WAYNE

date well completed

RT. firm name X 3/4

county well located

WAYNESBORO, MISS. 39367

LANDOWNER:
Stuart McLain
Waynesboro Ms
(mailing address)

description of formations encountered	from	to
Red SANDY CLAY	0	15
SAND & CLAY	15	20
FINE SAND	20	30
Med. SAND	30	50
SAND	50	65

WELL LOCATION:
sec. 35 T 7 N R. 8 E
7 miles SW of Clara
(distance) (direction) (nearest town)

WELL PURPOSE: HOME
(home, irrigation, municipal, industrial)

- WELL COMPLETION DATA:
- (1) diameter (inches) 2"
 - (2) total depth (feet) 65'
 - (3) static water level (feet) 19 1/2 below top of ground.
 - (4) casing PVC, 60'
(material) (depth)
2" if telescope see back.
(size)
 - (5) screen 5', 60'
(length) (depth to top)
2", PVC .008
(size) (material)
 - (6) pump 1 11
(HP) (yield gpm)
220 AC
(type power)
 - (7) electric log No
(yes or no)
 - (organization running log)
 - (8) how well bottom plugged


DRILLERS REMARKS:

RECEIVED
OCT 26 1978

MISS. Bd. of WATER COMM

If well telescopes please sketch and show depths.

GROUND LEVEL

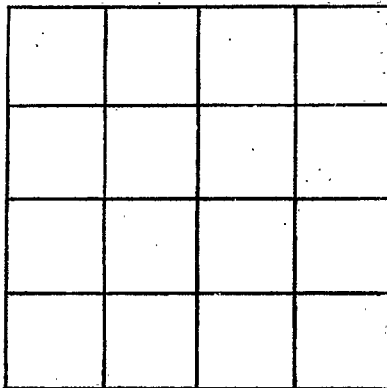

SECTION _____

Please indicate well location X.

ADDITIONAL INFORMATION

If more than one screen,
show locations of each on sketch.