

A 2007

5/9/79

416 North State Street
Jackson, Mississippi 39201

WATER WELL DRILLERS LOG

May 9

date well completed

WATER WELL SERVICE
RT 2 BOX 37

WAYNESBORO, MISS. 39367

Wayne

county well located

LANDOWNER:

Lloyd Mc LAIN

Waynesboro Ms.

(mailing address)

description of formations encountered

from

to

Red Sand

0

6

Sandy Clay

6

18

White Coarse Sand

12

78

WELL LOCATION:

sec. 1 T 7 N R 8 E

5 miles NW CLARA

(distance) (direction) of (nearest town)

WELL PURPOSE:

Home
(home, irrigation, municipal, industrial)

WELL COMPLETION DATA:

- (1) diameter (inches) 2"
- (2) total depth (feet) 78'
- (3) static water level (feet) 27' below above top of ground.
- (4) casing PVC 73' (material) (depth)
2" (size) if telescope see back.
- (5) screen 5' 13' (length) (depth to top)
2" PVC .008 (size) (material)
- (6) pump 1 12 (HP) (yield gpm)
220 AC (type power)
- (7) electric log No (yes or no)

(organization running log)

(8) how well bottom plugged

DRILLERS REMARKS:

Miss. Board of Water Comm.


JUN 14 1979

RECEIVED

If well telescopes please sketch and show depths.

MANUAL

GROUND LEVEL

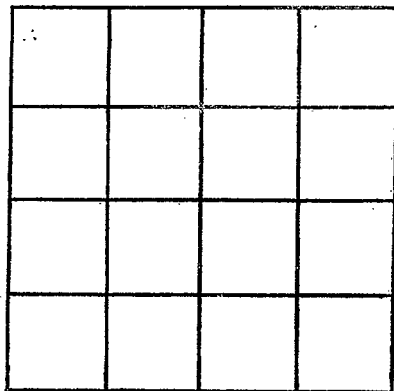

SECTION _____

Please indicate well location X.

ADDITIONAL INFORMATION

A series of horizontal lines for recording additional information, starting below the 'ADDITIONAL INFORMATION' header and extending to the bottom of the page.

If more than one screen, show locations of each on sketch.