

WAYNE
R 2008

MISSISSIPPI
BOARD OF WATER COMMISSIONERS
416 North State Street
Jackson, Mississippi 39201

WATER WELL DRILLERS LOG

2/19 1987 CARB'S WELL SER WAYNE
date well completed firm name county well located

LANDOWNER: JAMES PERRY
RT. 3 WAYNESBORO
MS. 39367
(mailing address)

WELL LOCATION:
sec. 13 T 7 N R 8 E
S W
5 miles W SW of CIABA
(distance) (direction) (nearest town)

WELL PURPOSE:
(home, irrigation, municipal, industrial)

- WELL COMPLETION DATA:
- (1) diameter (inches) 2'
 - (2) total depth (feet) 220
 - (3) static water level (feet) 91 ^{below} _{above} top of ground.
 - (4) casing PVC, 215' (depth)
2' (size) If telescope see back.
 - (5) screen 5', 215' (length) (depth to top)
8 SI, PVC (size) (material)
 - (6) pump 1 (HP) 6 (yield gpm)
ELEC (type power)
 - (7) electric log NO (yes or no)
 - (organization running log)
 - (8) how well bottom plugged B.W.V.

DRILLERS REMARKS:

description of formations encountered	from	to
CLAY	0	27
SD. MED. FINE	27	38
CLAY	38	175
FINE SD.	175	179
CLAY	179	213
SD. MED COURSE	213	219
SOME CHALK	219	220


RECEIVED

FEB 26 1987

Department of Natural Resources
Bureau of Land & Water Resources

If well telescopes please sketch and show depths.

GROUND LEVEL

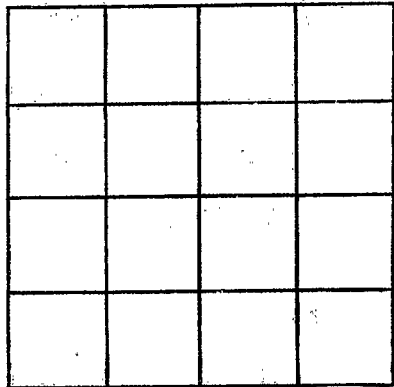

SECTION _____

Please indicate well location X.

ADDITIONAL INFORMATION

A series of 18 horizontal lines provided for entering additional information.

If more than one screen, show locations of each on sketch.