

WAYNE  
R 200  
12/2/77

MISSISSIPPI  
BOARD OF WATER COMMISSIONERS  
416 North State Street  
Jackson, Mississippi 39201

WATER WELL DRILLERS LOG

Dec 2 1977 Porter Drilling Wayne  
date well completed firm name county well located

LANDOWNER: J. Lee Cooley  
P.O. Box 3 Magneshboro Miss  
(mailing address)

WELL LOCATION:  
sec. 17 T. 70 N. R. 8 E.  
7 miles W of Clara  
(distance) (direction) (nearest town)

WELL PURPOSE: home  
(home, irrigation, municipal, industrial)

WELL COMPLETION DATA:  
(1) diameter (inches) 2"  
(2) total depth (feet) 291'  
(3) static water level (feet) 122' below above top of ground.  
(4) casing P.V.C. 276'  
(material) (depth)  
2' if telescope see back.  
(size)  
(5) screen 5' 276'  
(length) (depth to top)  
2' 6 stud S.S.  
(size) (material)  
(6) pump 2 5  
(HP) (yield gpm)  
elec.  
(type power)  
(7) electric log no  
(yes or no)  
(organization running log)  
(8) how well bottom plugged  
1 1/2' back wash valve

description of formations encountered	from	to
red sand & clay	0	25
clay	25	192
clay & sand	192	270
med. coarse sand	270	281
interst. white shell		
sub. sand		
5' 2" bsh. SS with 1 1/2" back wash valve on end & shell trap above		
40' 1" P.V.C. pipe		


RECEIVED  
JAN 27 1978

MISS. BD. OF WATER COMM.

DRILLERS REMARKS:

If well telescopes please sketch and show depths.

GROUND LEVEL

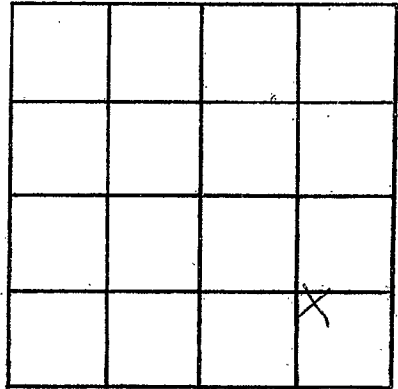

SECTION 17

Please indicate well location X.

ADDITIONAL INFORMATION

If more than one screen,  
show locations of each on sketch.