

R 2011

MISSISSIPPI DEPARTMENT OF ENVIRONMENTAL QUALITY

Office of Land and Water Resources

P. O. Box 10631
Jackson, MS 39289-0631

WATER WELL DRILLERS LOG

COUNTY WELL LOCATED WAYNE	
WELL NUMBER WSH	CODED
2-2 #1	
DATE WELL COMPLETED 6/02/2000	

PERMIT NUMBER D-402
NAME OF DRILLING FIRM Tom Griffith
Water Well

NAME & MAILING ADDRESS OF LANDOWNER NaBors Drilling Co			
P.O. Box 6514			
Lamel, MS 39441			
WELL LOCATION	SEC.	TOWNSHIP	RANGE
	2	7	N 8 E
DISTANCE	DIRECTION	NEAREST TOWN	
5 Miles	W	Clarks	
OTHER LANDMARK			
WELL PURPOSE Home, Irrigation, Municipal, Industrial, Fish Pond, etc. Rig Supply			

PUMP DATA		
PUMP TYPE (Circle One): <input checked="" type="radio"/> Submersible, <input type="radio"/> Turbine, <input type="radio"/> Jet, <input type="radio"/> Flowing Well, Other (Describe) _____		
POWER TYPE (Circle One): <input checked="" type="radio"/> Electric, <input type="radio"/> Tractor, <input type="radio"/> Diesel, <input type="radio"/> Gasoline, <input type="radio"/> Butane, Other (Describe) _____ H/P _____		
Pump Capacity (GPM)	No. of Stages	Setting Depth FT.
PUMP TEST		
Well yielded 50 GPM with a drawdown of Air Lift ft. after _____ hours of pumping		

WELL DATA		
Well Depth 450	Casing Diameter (In) 4	Casing Length (Ft) 410
Type of Casing PVC	Hole Depth 450	Depth to Static Water Level 85

LOG DATA	
TYPE OF LOG RUN (Circle One): <input type="radio"/> No Log Run, <input type="radio"/> Electric, <input type="radio"/> Gamma Ray, <input type="radio"/> Density, <input type="radio"/> Sonic, <input type="radio"/> Neutron, Other (Describe) _____	
Name of Organization Running Log	

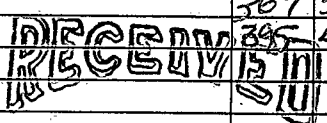
TYPE OF COMPLETION: (Circle One or More): <input checked="" type="radio"/> Gravel Packed, <input type="radio"/> Underreamed, <input type="radio"/> Telescoped, <input type="radio"/> Natural Development, <input type="radio"/> Open Hole, <input type="radio"/> Other (Describe) _____			
WELL GROUTED TO A DEPTH OF 10 FEET Type Grout (circle one): Cement, Bentonite, or Mix			

GEOLOGIC DATA (Office Use Only)			
Surface Elev.	Geologic Unit	Unit Thickness	Depth to Top
Subs. SWL	Date	Analysis	Aquifer Test

SCREEN DATA		
Diameter - Inches 4	Length - Feet 40	Slot Size - Inches .010
Screen Type PVC 56t	Depth to Bottom - Feet 0	

Driller's Remarks	
Top of Lap Pipe or Reduction in Casing	
FEET	IF TELESCOPED OR MORE THAN ONE SCREEN: USE BACK PAGE

DESCRIPTION OF FORMATIONS ENCOUNTERED	FROM	TO
Hard slate	0	2
Hard clay	2	58
Fine sand	58	125
clay	125	150
SAND	150	158
clay	158	225
SAND	225	255
Rock	255	256
clay	256	295
SAND	295	310
clay	310	364

FORMATIONS (Continued)	FROM	TO
Rock	364	367
clay	367	395
SAND	395	450
		
MAR 16 2000		
Dept. of Environmental Quality Office of Land & Water Resources		

IF MORE SPACE IS NEEDED, USE BACK

If well telescopes please
sketch and show depths.

GROUND LEVEL

SECTION _____

Please indicate well location X.

ADDITIONAL INFORMATION

If more than one screen,
show location of each on sketch.