

S3

11-9-63

WATER WELL DRILLERS LOG

Date: Nov 9, 1963, Driller: Porter Drilling & Supply County Wayne
 (Name)

(1) Owner of Land: Mrs Day
 (Name)
At 3 Waynesboro Miss
 (Address)
 (2) Location: NW 1/4, NE 1/4, Sec. 10 T7 R7
2 miles NE of Clara
 (distance) (direction) (Nearest Town)
 (3) Topography: hilly
 (Hilly) (Flat) (Level)
 (4) Purpose of Well: domestic
 (Domestic Irrigation
 Municipal, Industrial, Other)


Description & Color of Materials Sand, Clay, Red Clay, Shell, etc.	Thick- ness Feet	Depth Feet
sandy clay	8	8
sand & chalk	22	30
soft chalk	24	54
blue chalk	32	86
fine sand	4	90
blue chalk	11	101
hard fine sand	4	105
blue chalk	8	113
hard coarse sand	5	118
chalk	33	151
fine rock	6	157
hard chalk	6	183
fine sand	6	189
chalk	15	204
course sand would reproduce water	6	210
chalk	7	217
rock	1	218
blue chalk	10	228
clean course sand	4	232
streaks of sand & chalk	6	238
clean course sand	3	241
chalk	4	245

Information upon completion of well:

(1) Diameter 2" inches.
 (2) Total Depth 245' feet.
 (3) Water Level 103' feet below top of ground.
 (4) Cased to 231', Size 2"
 (5) Screen: Size 1/4", Length 5'
Johnson S. S. .008"
 (6) Were any formations sealed against pollution?
 yes, no.

If YES depth of formation _____
 Why _____

Drillers Remarks: 4' of pipe below screen
6' " 1/4" lap pipe into case

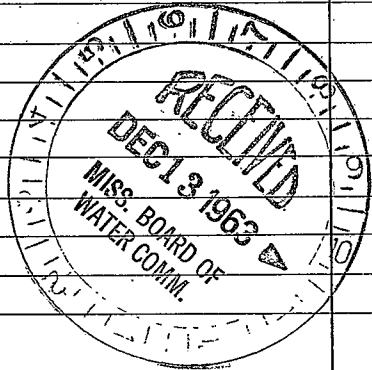

(Use Back Side)

Well No.

