

WAYNE MISSISSIPPI BOARD OF WATER COMMISSIONERS

SA

11-6-63

WATER WELL DRILLERS LOG

Date: Nov 6, 1963, Driller: Porter Drilling Co Wayne County Wayne
 (Name)


(1) Owner of Land: Cliff Kutto
 (Name)
Rt 3 Waynesboro
 (Address)
 (2) Location: SE 1/4, NE 1/4, Sec. 10 T. 7 R. 7
2 miles NE of Claw
 (distance) (direction) (Nearest Town)
 (3) Topography: hilly
 (Hilly) (Flat) (Level)
 (4) Purpose of Well: domestic
 (Domestic Irrigation
 Municipal, Industrial, Other)

Description & Color of Materials Sand, Clay, Red Clay, Shell, etc.	Thick- ness Feet	Depth Feet
red clay	6	6
red chert	21	27
sand	2	29
blue chalk	30	59
red sand & chert	10	69
blue chalk	9	78
course red sand	2	80
red chert & red sand		
streaky	28	108
blue chalk	42	150
tuff fine sand	10	160
ropy chalk	18	178
hard chalk	11	189
hard thin rock		189
blue chalk	7	196
sand & streaks of chalk	24	220

Information upon completion of well:

(1) Diameter 2" inches.
 (2) Total Depth 220' feet.
 (3) Water Level 88' feet below top of ground.
 (4) Cased to 200', Size 2"
 (5) Screen: Size 1 1/4", Length 12'
6' 60 ga on bottom 4' deep 6' 60
 (6) Were any formations sealed against pollution?
ga. on top 5' deep
 yes, X no.

If YES depth of formation _____
 Why _____
 Drillers Remarks: _____

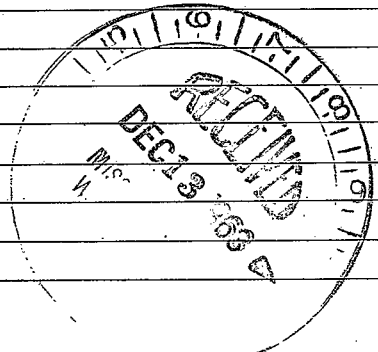

(Use Back Side)

Well No.

[The page contains extremely faint and illegible text, likely bleed-through from the reverse side of the document. No specific content can be transcribed.]