

WAYNE MISSISSIPPI BOARD OF WATER COMMISSIONERS

S5

10-15-63

WATER WELL DRILLERS LOG

Date: Oct 15, 1963, Driller: Porter Drilling Co. Lye County, Wayne
 (Name)

(1) Owner of Land: Horace Beedy
 (Name)

At 3 Magneshoro
 (Address)

(2) Location: NE 1/4, NW 1/4, Sec. 33 T.7R.7.

4 miles S of Clava
 (distance) (direction) (Nearest Town)

(3) Topography: Hilly
 (Hilly) (Flat) (Level)

(4) Purpose of Well: domestic
 (Domestic Irrigation
 Municipal, Industrial, Other)

Description & Color of Materials Sand, Clay, Red Clay, Shell, etc.	Thick- ness Feet	Depth Feet
<u>over clay</u>	<u>9</u>	<u>9</u>
<u>dry sand</u>	<u>12</u>	<u>21</u>
<u>yellow chalk</u>	<u>15</u>	<u>36</u>
<u>blue chalk</u>	<u>48</u>	<u>84</u>
<u>streaks of fine</u> <u>sand & chalk</u>	<u>12</u>	<u>96</u>
<u>cleaned sand</u> <u>stopped on chalk</u>	<u>7</u>	<u>103</u>

Information upon completion of well:

(1) Diameter 2" inches.

(2) Total Depth 103' feet.

(3) Water Level 55' feet below top of ground.

(4) Cased to 96', Size 2"

(5) Screen: Size 6', Length 1 1/4"


(6) Were any formations sealed against pollution?

no yes, no.

If YES depth of formation _____

Why _____

Drillers Remarks: _____

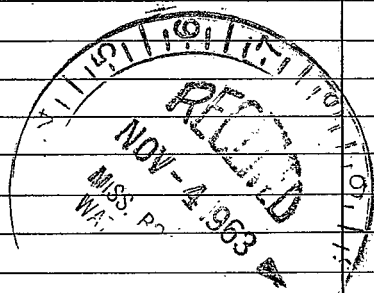

(Use Back Side)

Well No.

