

S7

10-23-63

WATER WELL DRILLERS LOG

Date: Oct 23, 1963, Driller: Porter Drilling & Log Co. Wayne

(Name)

(1) Owner of Land: William Lofton

(Name)

RT 3 Waynesboro, Miss

(Address)

(2) Location: NW 1/4, NE 1/4, Sec. 10 T 7 R 2

2 miles NE of Clara

(distance)

(direction)

(Nearest Town)

(3) Topography: hilly

(Hilly)

(Flat)

(Level)

(4) Purpose of Well: domestic

(Domestic Irrigation  
Municipal, Industrial, Other)

Description & Color of Materials Sand, Clay, Red Clay, Shell, etc.	Thick- ness Feet	Depth Feet
oest clay	8	8
chalk	10	18
blue chalk	23	41
thin rock		41
red chalk mixed with fine sand	38	79
lost circulation in loose chalk at 74'		
thin rock		79
blue chalk	47	126
red chalk	10	136
blue chalk	9	145
oest blue sand mixed with chalk	12	157

Information upon completion of well:

(1) Diameter 2" inches.

(2) Total Depth 157' feet.

(3) Water Level 59' feet below top of ground.

(4) Cased to 146', Size 2"

(5) Screen: Size 1 1/4", Length 12'


(6) Were any formations sealed against pollution?

\_\_\_\_\_ yes, X no.

If YES depth of formation \_\_\_\_\_

Why \_\_\_\_\_

Drillers Remarks: \_\_\_\_\_

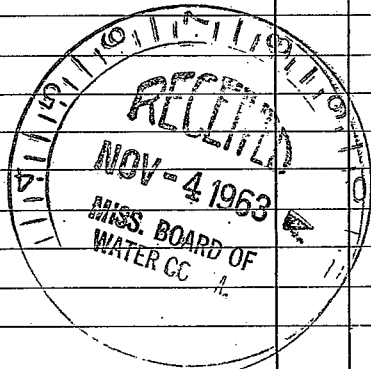

(Use Back Side)

Well No.

