

WAYNE MISSISSIPPI BOARD OF WATER COMMISSIONERS

S 8

7-8-63

WATER WELL DRILLERS LOG

Date: July 8, 1963, Driller: Porter Drilling & Log County: Wayne
(Name)

(1) Owner of Land: Audrey Cook
(Name)
Rt 3 Waynesboro
(Address)

(2) Location: NW 1/4, NE 1/4, Sec 10 T 7 R 7
6 miles south of Waynesboro
(distance) (direction) (Nearest Town)

(3) Topography: Hilly
(Hilly) (Flat) (Level)

(4) Purpose of Well: domestic
(Domestic Irrigation Municipal, Industrial, Other)

Description & Color of Materials Sand, Clay, Red Clay, Shell, etc.	Thick-ness Feet	Depth Feet
red clay	6	6
red sand	9	15
yellow chalk	10	25
blue chalk	40	65
red/brown chalk	5	70
blue chalk	18	88
fine light sand	2	90
blue chalk	9	99
fine light sand	3	102
blue chalk	67	169
fine clean sand	10	179
strata of sand & chalk	49	228
med clean sand	2	230
strata of sand & chalk	34	264
med clean sand	3	267
coarse clean sand	3	270
blue chalk	2	272

Information upon completion of well:

(1) Diameter: 2" inches.

(2) Total Depth: 270' feet.

(3) Water Level: 92' feet below top of ground.


(4) Cased to: 228, Size: 2"

(5) Screen: Size: 1 1/4", Length: 12'

(6) Were any formations sealed against pollution?
yes, no.

If YES depth of formation _____
 Why _____

Drillers Remarks: 2' of 1 1/4" on bot.
6' 80 gal. scr.
3' 1 1/4" pipe
6' 60 gal. scr.

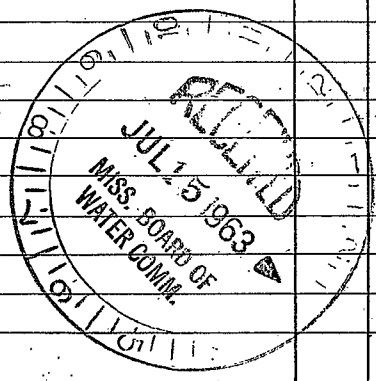

(Use Back Side)

Well No.

