

S9

8-9-63

WATER WELL DRILLERS LOG

Date: Aug 9, 1963, Driller: Porter Drilling & Supply Co. County: Wayne

- (1) Owner of Land: Henry E Palmer (Name) At 3 Hayesboro, Miss (Address) (2) Location: SW 1/4, NW 1/4, Sec. 8 T7R7, 1 1/2 miles NW of Clara (distance) (direction) (Nearest Town) (3) Topography: hilly (Hilly) (Flat) (Level) (4) Purpose of Well: domestic (Domestic Irrigation Municipal, Industrial, Other)


Table with columns: Description & Color of Materials, Thickness Feet, Depth Feet. Rows include: red clay (8, 8), sand (16, 24), sand rock (1/2, 24 1/2), chalk (26 1/2, 51), sand (3, 54), chalk (10, 64), sand (3, 67), chalk (7, 74), sand & chalk (24, 93), sand (3, 96), chalk & sand (26, 122), sand chalk (17, 139), fine sand (17, 156), loose chalk & sand (10, 166), sand blue chalk (22, 188), sandstone to course (16, 204)

Information upon completion of well:

- (1) Diameter: 2" inches. (2) Total Depth: 204' feet. (3) Water Level: 33' feet below top of ground. (4) Cased to: 195', Size: 2". (5) Screen: Size: 1 1/4", Length: 9'. (6) Were any formations sealed against pollution? yes, X no.

If YES depth of formation: Why:

Drillers Remarks:

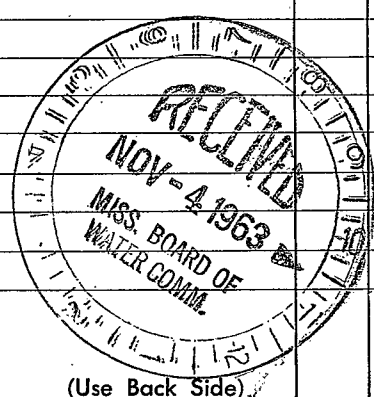

Well No.

(Use Back Side)

