

WAYNE

MISSISSIPPI BOARD OF WATER COMMISSIONERS

S 11

5-14-66

WATER WELL DRILLERS LOG

Date: May 14, 1966, Driller: Porter Drilling & Pump Co., Wayne  
 (Name)

(1) Owner of Land: Clara Water Sys  
 (Name)  
Clara, Miss  
 (Address)

(2) Location: NW 1/4, NE 1/4, Sec. 10 T7R7  
2 miles NE of Clara  
 (distance) (direction) (Nearest Town)

(3) Topography: hilly  
 (Hilly) (Flat) (Level)

(4) Purpose of Well: test hole  
 (Domestic Irrigation  
 Municipal, Industrial, Other)

Description & Color of Materials Sand, Clay, Red Clay, Shell, etc.	Thick- ness Feet	Depth Feet
red sand & clay	8	8
red chalk	12	20
chalk & sand	20	40
sand	20	60
red chalk	6	66
light blue chalk	26	92
fine sand	8	100
red chalk	20	120
chalk & sand streaks	43	163
clean fine sand	7	170
chalk	12	182
sand & chalk streaks	27	209
clean coarse sand	7	216
sand & chalk streaks	11	227
clean coarse sand	12	239
sand & chalk streaks	21	260
med fine sand some chalk	24	284
blue chalk	6	290
clean med sand	22	312
med coarse sand	10	322
coarse sand	15	337
blue chalk	3	340
rock strata	10	350
blue chalk	12	362
rock strata	13	375
blue chalk	103	478
Wicksburg lime zone	25	503
white chalk zone		
blue chalk	36	539
blue chalk	3	542

Information upon completion of well:

(1) Diameter 2" inches.

(2) Total Depth 542' feet.  
 water level 112' in sand 290' to 337'

(3) Water Level 147' feet below top of ground.  
in Vicksburg

(4) Cased to 325' in sand. Size 2"  
 Cased to 478' top of Vicksburg


(5) Screen: Size 1/4", Length 12'  
none used in Vicksburg

(6) Were any formations sealed against pollution?  
yes, X no.

If YES depth of formation \_\_\_\_\_

Why \_\_\_\_\_

Drillers Remarks: \_\_\_\_\_

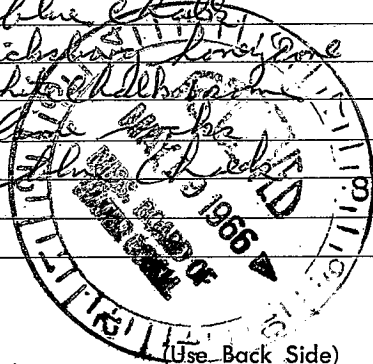

Well No.

