

WAYNE MISSISSIPPI BOARD OF WATER COMMISSIONERS

S 12

8-20-63

WATER WELL DRILLERS LOG

Date: Aug 20, 1963, Driller: Porter Drilling & Supply Co. County Wayne
 (Name)

(1) Owner of Land: L. C. Cause
 (Name)
Box 11 Clara Miss
 (Address)
 (2) Location: NW 1/4, SE 1/4, Sec. 8 T7R7,
1 miles NW, of Clara,
 (distance) (direction) (Nearest Town)
 (3) Topography: Hilly
 (Hilly) (Flat) (Level)
 (4) Purpose of Well: domestic
 (Domestic Irrigation
 Municipal, Industrial, Other)


Description & Color of Materials Sand, Clay, Red Clay, Shell, etc.	Thick- ness Feet	Depth Feet
<u>hard clay</u>	<u>7</u>	<u>7</u>
<u>sandy clay</u>	<u>9</u>	<u>16</u>
<u>red sand</u>	<u>4</u>	<u>20</u>
<u>pea gravel</u>	<u>2</u>	<u>22</u>
<u>red sand</u>	<u>2</u>	<u>24</u>
<u>blue chalk</u>	<u>26</u>	<u>50</u>
<u>rock</u>	<u>1/2</u>	<u>50 1/2</u>
<u>sand</u>	<u>9 1/2</u>	<u>60</u>

Information upon completion of well:

(1) Diameter 2" inches.
 (2) Total Depth 60' feet.
 (3) Water Level 34' feet below top of ground.
 (4) Cased to 53', Size 2"
 (5) Screen: Size 1/4", Length 6'
 (6) Were any formations sealed against pollution?
 _____ yes, X no.

If YES depth of formation _____
 Why _____

Drillers Remarks: _____

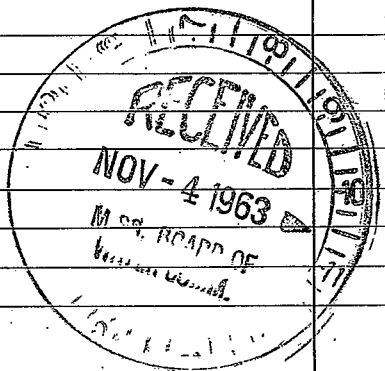

(Use Back Side)

Well No.

