

WAYNE MISSISSIPPI BOARD OF WATER COMMISSIONERS

S 13

5-1763

WATER WELL DRILLERS LOG


Date: May 17, 1963, Driller: Porter Drilling & Log Co County: Wayne
 (Name)

- (1) Owner of Land: Paul Singleton
 (Name)
At 3 Waynesboro Miss
 (Address)
- (2) Location: NE 1/4, SW 1/4, Sec. 1 T7R7,
5 miles south, of Waynesboro
 (distance) (direction) (Nearest Town)
- (3) Topography: hilly
 (Hilly) (Flat) (Level)
- (4) Purpose of Well: domestic
 (Domestic Irrigation
 Municipal, Industrial, Other)

Description & Color of Materials Sand, Clay, Red Clay, Shell, etc.	Thick- ness Feet	Depth Feet
<u>red clay</u>	<u>8</u>	<u>8</u>
<u>chalk</u>	<u>7</u>	<u>15</u>
<u>sandy chalk</u>	<u>8</u>	<u>23</u>
<u>sand</u>	<u>9</u>	<u>32</u>

Information upon completion of well:

- (1) Diameter 2" inches.
- (2) Total Depth 32 feet.
- (3) Water Level 22' feet below top of ground.
- (4) Cased to 27', Size 2"
- (5) Screen: Size 1/4", Length 5'
S.S. Johnson
- (6) Were any formations sealed against pollution?
no

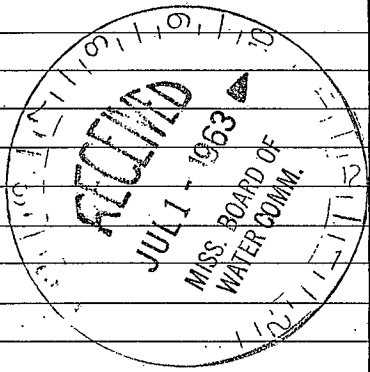

If YES depth of formation _____
 Why _____
 Drillers Remarks: _____

(Use Back Side)

Well No.

