

WAYNE MISSISSIPPI BOARD OF WATER COMMISSIONERS

S14

9-30-63

WATER WELL DRILLERS LOG

Date: Sept 30, 1963, Driller: Porter Drilling & Pump Co. Wayne
 (Name)

(1) Owner of Land: Ind. Church of God
 (Name)
P.O. 3 Waynesboro, Miss
 (Address)

(2) Location: SW 1/4, SE 1/4, Sec. 15 T. 2 R. 7
1 1/2 miles S. E. of Clara
 (distance) (direction) (Nearest Town)

(3) Topography: Hilly
 (Hilly) (Flat) (Level)

(4) Purpose of Well: Domestic
 (Domestic Irrigation
 Municipal, Industrial, Other)

Description & Color of Materials Sand, Clay, Red Clay, Shell, etc.	Thick-ness Feet	Depth Feet
<u>red clay</u>	<u>6</u>	<u>6</u>
<u>hard ch. sh.</u>	<u>18</u>	<u>24</u>
<u>hard blue ch. sh.</u>	<u>16</u>	<u>40</u>
<u>sand & ch. sh. mixed</u>	<u>17</u>	<u>57</u>
<u>course red sand</u>	<u>3</u>	<u>60</u>
<u>rock</u>		<u>60</u>

Information upon completion of well:

(1) Diameter 2" inches.

(2) Total Depth 57' feet.

(3) Water Level 38' feet below top of ground.


(4) Cased to 4.5', Size 2"

(5) Screen: Size 1 1/4", Length 12'

(6) Were any formations sealed against pollution?
 _____ yes, X no.

If YES depth of formation _____
 Why _____

Drillers Remarks: _____

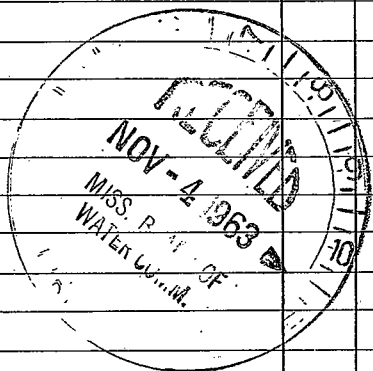

(Use Back Side)

Well No.

