

S15

10-25-63

WATER WELL DRILLERS LOG

Date: Oct 25, 1963, Driller: Porter Drilling & Supply County Wayne
 (Name)

(1) Owner of Land Arthur Lee Heathcock
 (Name)
Box 3 Magnolia
 (Address)
 (2) Location: NW 1/4, NE 1/4, Sec. 10 T7R7
6 miles south of Magnolia
 (distance) (direction) (Nearest Town)
 (3) Topography: Hilly
 (Hilly) (Flat) (Level)
 (4) Purpose of Well: domestic
 (Domestic Irrigation
 Municipal, Industrial, Other)


Description & Color of Materials Sand, Clay, Red Clay, Shell, etc.	Thick- ness Feet	Depth Feet
<u>red clay</u>	<u>8</u>	<u>8</u>
<u>sand</u>	<u>4</u>	<u>12</u>
<u>yellow chalk</u>	<u>6</u>	<u>18</u>
<u>blue chalk</u>	<u>47</u>	<u>65</u>
<u>mixed sand & chalk</u>	<u>5</u>	<u>70</u>
<u>chalk</u>	<u>5</u>	<u>75</u>
<u>sand</u>	<u>10</u>	<u>85</u>
<u>blue chalk</u>	<u>2</u>	<u>87</u>

Information upon completion of well:

(1) Diameter 2" inches.
 (2) Total Depth 87' feet.
 (3) Water Level 66' feet below top of ground.
 (4) Cased to 75', Size 2"
 (5) Screen: Size 1 1/4", Length 12'
 (6) Were any formations sealed against pollution?
 _____ yes, X no.

If YES depth of formation _____
 Why _____

Drillers Remarks: _____

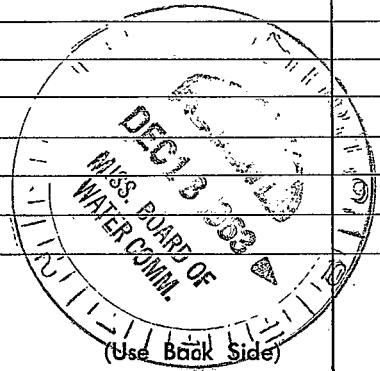

Well No. _____

