

WAYNE MISSISSIPPI BOARD OF WATER COMMISSIONERS

S 17

9-3-63

WATER WELL DRILLERS LOG

Date: Sept. 3, 1963, Driller: Porter Drilling & Log County Wayne
 (Name)

(1) Owner of Land: Mrs Ruby Gordon
 (Name)
Rt 3 Wagnersboro
 (Address)
 (2) Location: NW 1/4, NW 1/4, Sec. 15 T7R7
1 miles east, of Clara
 (distance) (direction) (Nearest Town)
 (3) Topography: level
 (Hilly) (Flat) (Level)
 (4) Purpose of Well: domestic
 (Domestic Irrigation
 Municipal, Industrial, Other)


Description & Color of Materials Sand, Clay, Red Clay, Shell, etc.	Thick- ness Feet	Depth Feet
<u>red clay & sand</u>	<u>10</u>	<u>10</u>
<u>blue chalk</u>	<u>50</u>	<u>60</u>
<u>mixed sand & chalk</u>	<u>4</u>	<u>64</u>
<u>sand</u>	<u>14</u>	<u>78</u>

Information upon completion of well:

(1) Diameter 2" inches.
 (2) Total Depth 78' feet.
 (3) Water Level 42' feet below top of ground.
 (4) Cased to 72', Size 2"
 (5) Screen: Size 1 1/4", Length 6'
 (6) Were any formations sealed against pollution?
 _____ yes, X no.

If YES depth of formation _____
 Why _____

Drillers Remarks: _____

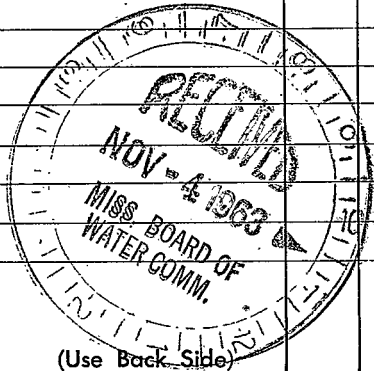

Well No.

